


T. 1S. R.3 W.W.M.

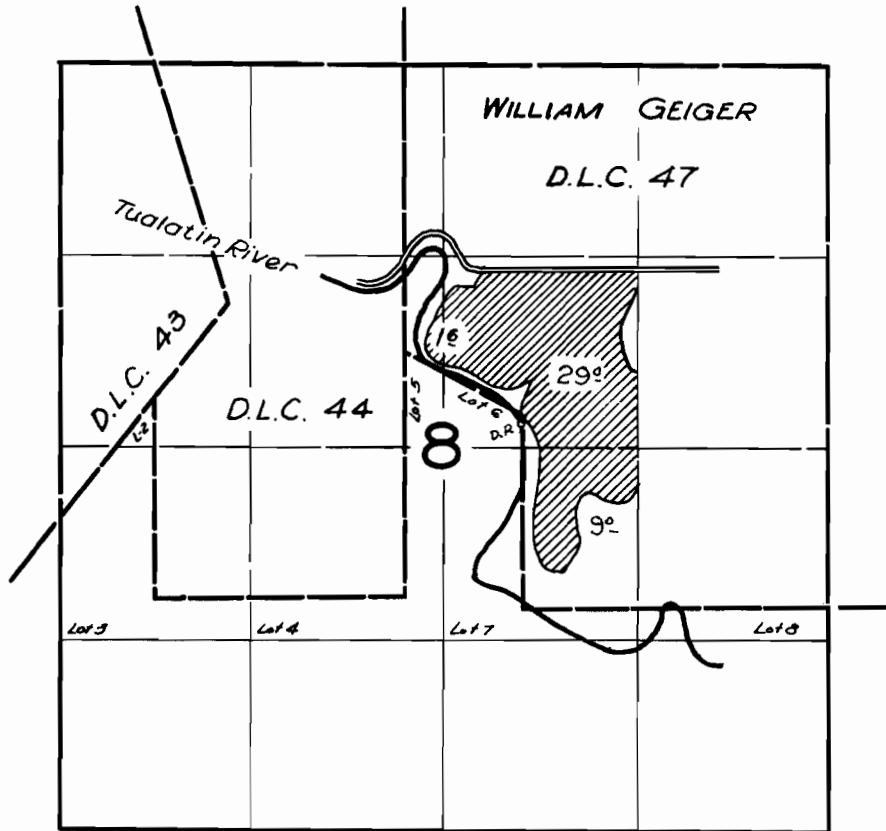

FINAL PROOF SURVEY
UNDER

Application No. 30597 Permit No. 24094
IN NAME OF

H. B. ALLEN

Surveyed 27 May 1959, by *R. Jackson*