


T.4S. R.2E.W.M.

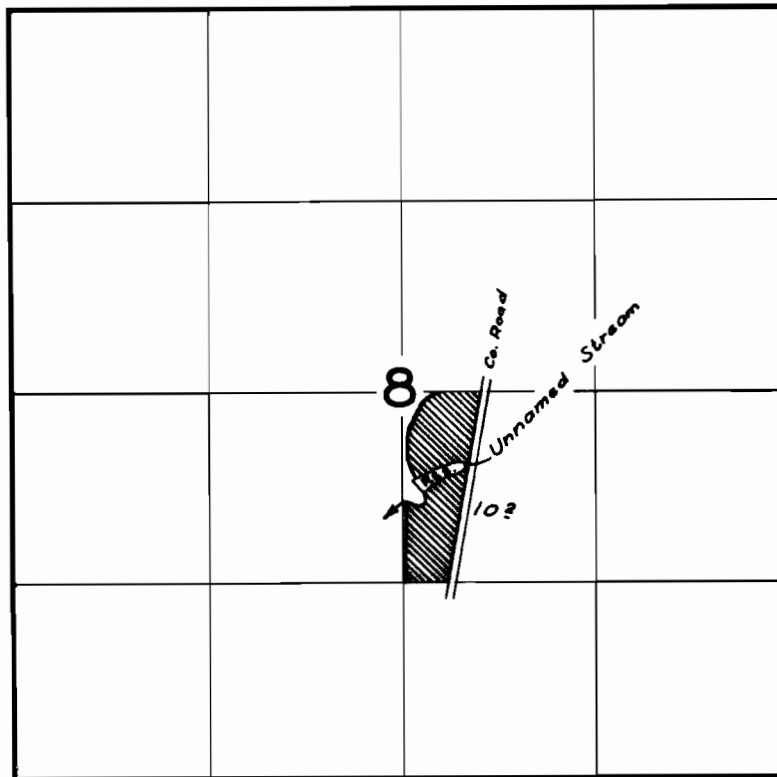

FINAL PROOF SURVEY
UNDER

R-30644 R-1847
Application No. 30645 Permit No. 24141
IN NAME OF

MARLIN BURLEY-BENJAMIN BURLEY

Surveyed 14 August 1958, by C.O. Bartels.