


T.4S. R.2E.W.M.

map from
file
R-30644

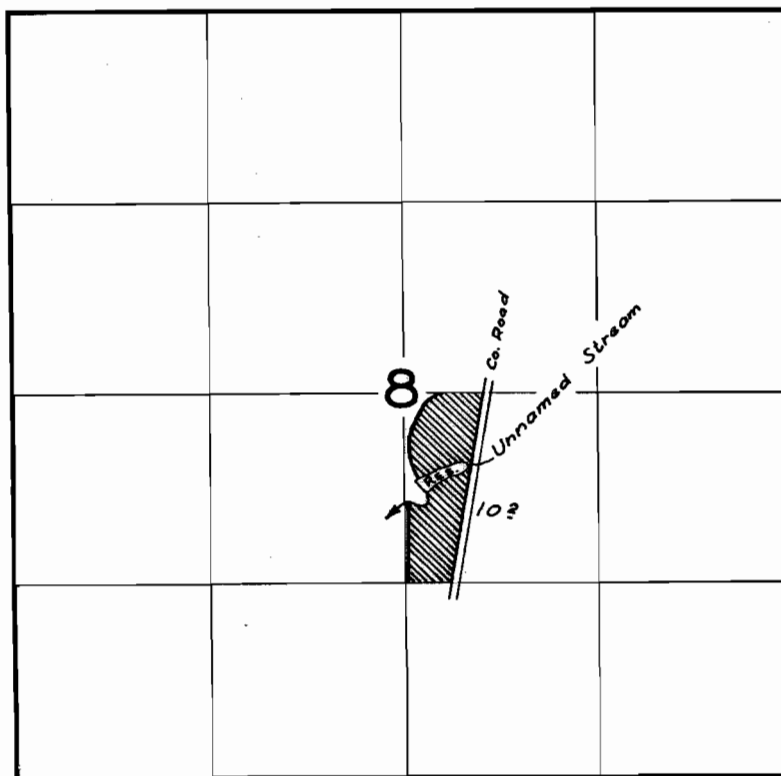

FINAL PROOF SURVEY
UNDER

R-30644 R-1847
Application No. 30645 Permit No. 24141.....
IN NAME OF

MARLIN BURLEY-BENJAMIN BURLEY

Surveyed 14 August 1958, by C.O. Bartels..