


T.19S. R.3 W.W.M.

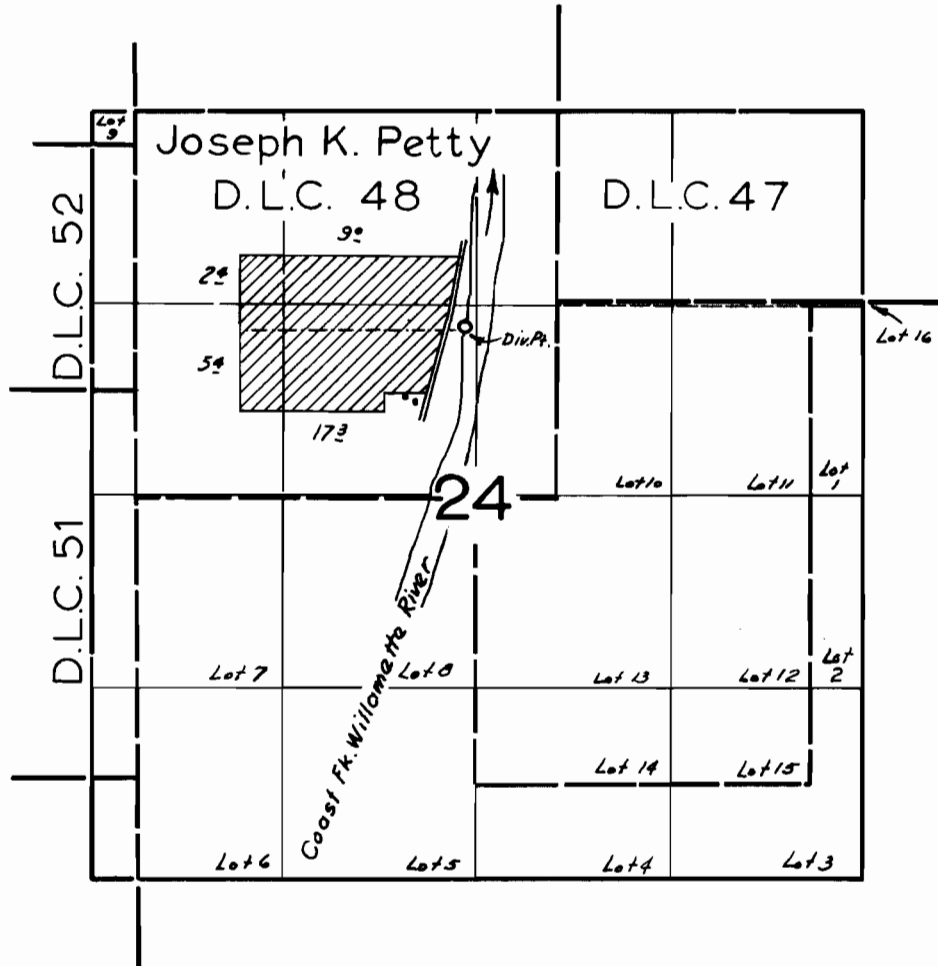

FINAL PROOF SURVEY
UNDER

Application No. 27364 Permit No. 24209.
IN NAME OF

HARRY S. & BERTHA M. HOLT

Surveyed Mar. 25, 1959, by *R.H. Jackson*