


T.11S. R. 6 W.W.M.

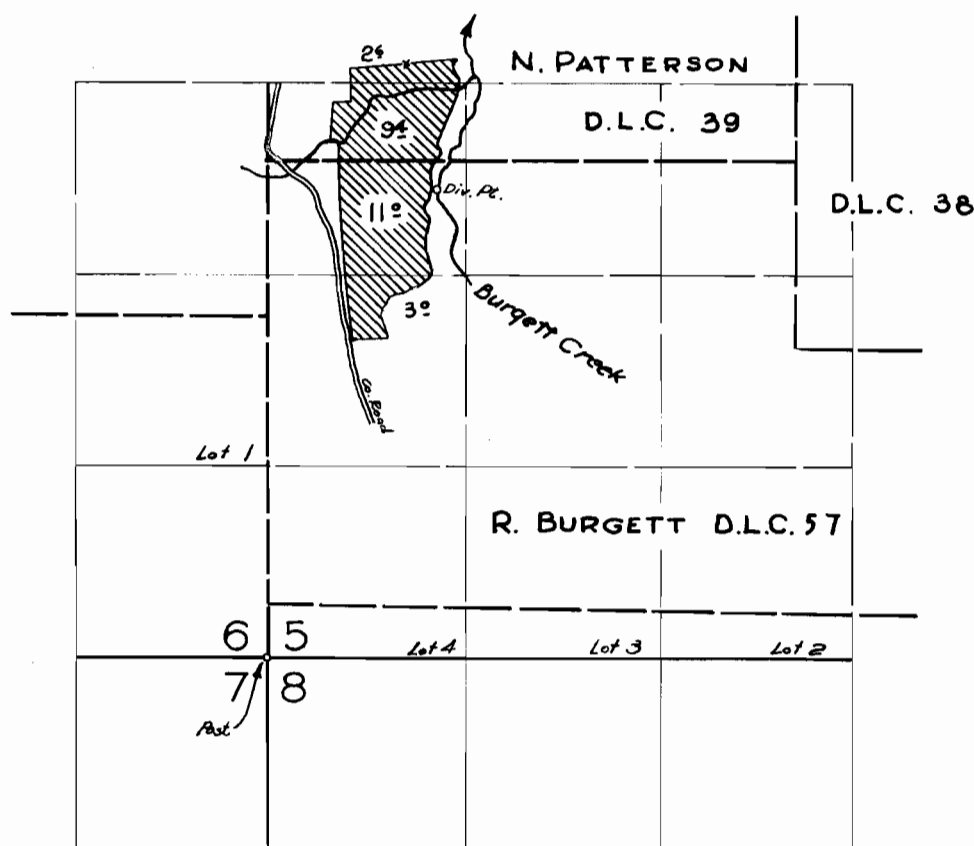

FINAL PROOF SURVEY
UNDER

Application No. 30740 Permit No. 24221
IN NAME OF

E. F. PANKALLA

17 Sept. '58 M. Bish
Surveyed 11 Mar. 1959, by R.H. Jackson