


T. 36 S. R. 6 W. W. M.

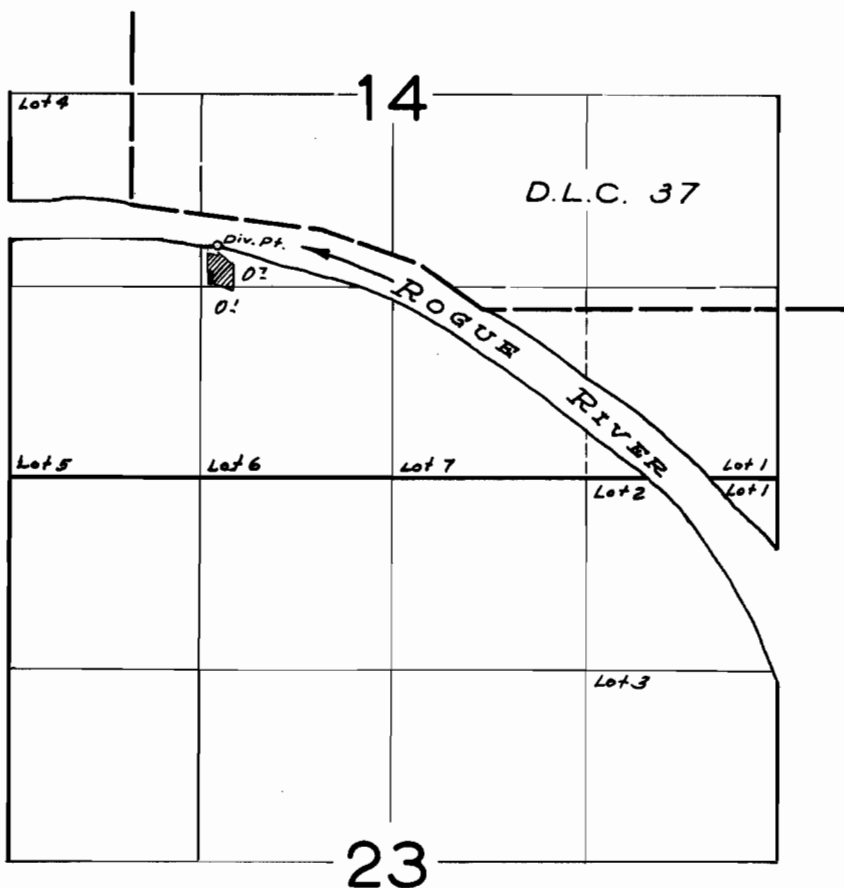

FINAL PROOF SURVEY
UNDER

Application No. 30835. Permit No. 24319...
IN NAME OF

BEN W. & FLORENCE B. COUTANT

Surveyed July 23, 1959, by *R. Jackson*