


T. 1 S. R. 2 W. W. M.

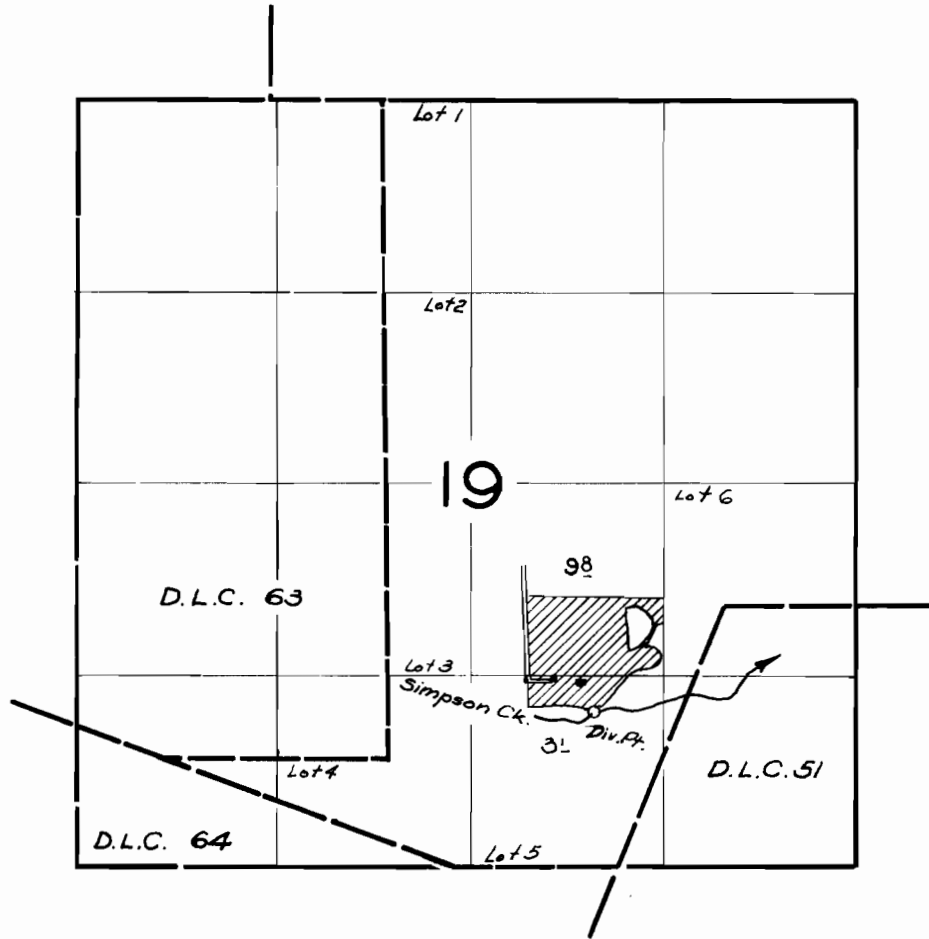

**FINAL PROOF SURVEY**  
UNDER

Application No. 30857. . . Permit No. 24324  
IN NAME OF

*ROBERT C. & MARIE ENSCHEDE*

Surveyed 2 June 1959, by *R. Jackson*