


T. 10S. R. 3&4 W. W.M.

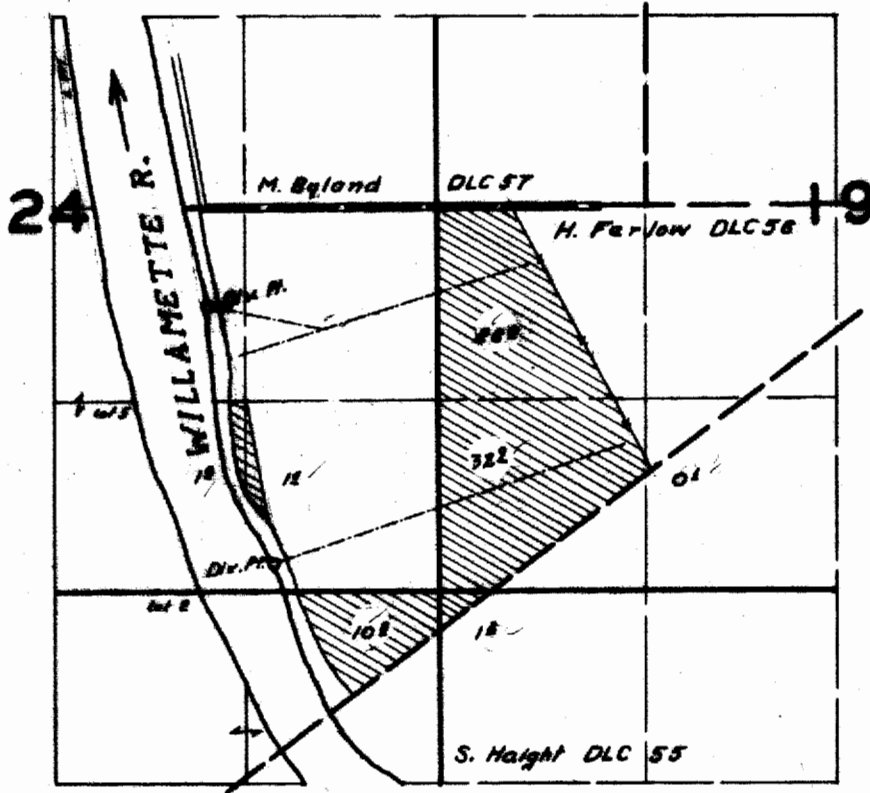

**FINAL PROOF SURVEY**  
UNDER

Application No. 3/34/ Permit No. 24788  
IN NAME OF

Elton I. & Mildred Higbee & Henry & Pauline Turnidge

Surveyed Sept. 9, 1959, by W. N. Perry