


T.10 S. R. 9W.W.M.

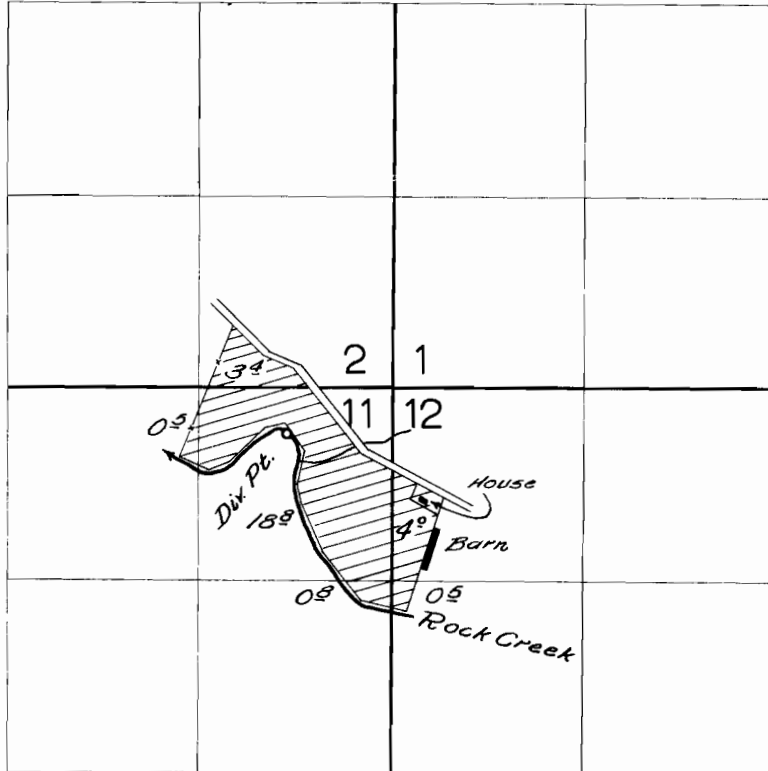

**FINAL PROOF SURVEY**  
UNDER

Application No. 31499 Permit No. 24851  
IN NAME OF

*Walter G. Bowman*

Surveyed April 22 1959, by *G. O. Baile*