


T. 15 S. R. 5 W. W. M.

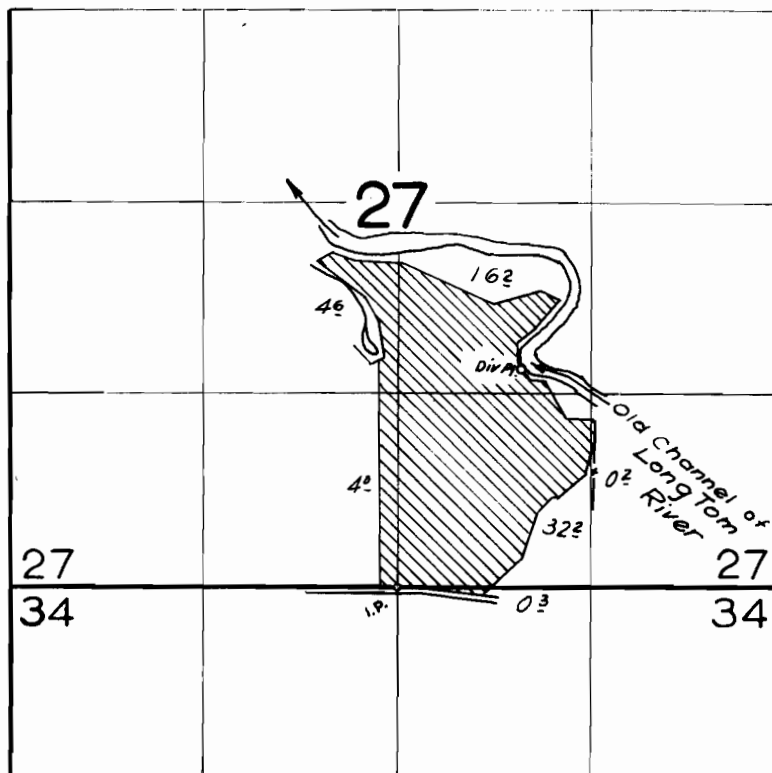

FINAL PROOF SURVEY
UNDER

Application No. 31584 Permit No. 24917
IN NAME OF

JUPE HOLM

Surveyed April 3 1959, by *R. H. Jackson*