


T.17S. R.12 W.W.M.

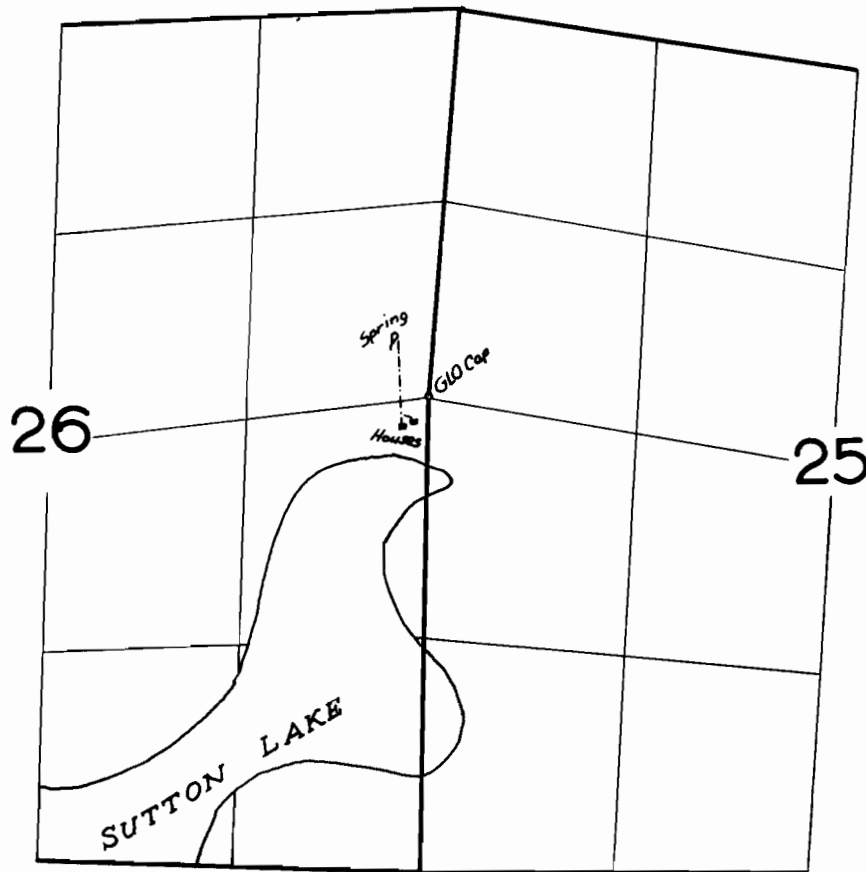

FINAL PROOF SURVEY
UNDER

Application No. 31599 . Permit No. 2496.9
IN NAME OF

HALE B. KILMER

Surveyed April 8 . 1959 , by *RH Jackson*