


T. 3S. R. 2E. W.M.

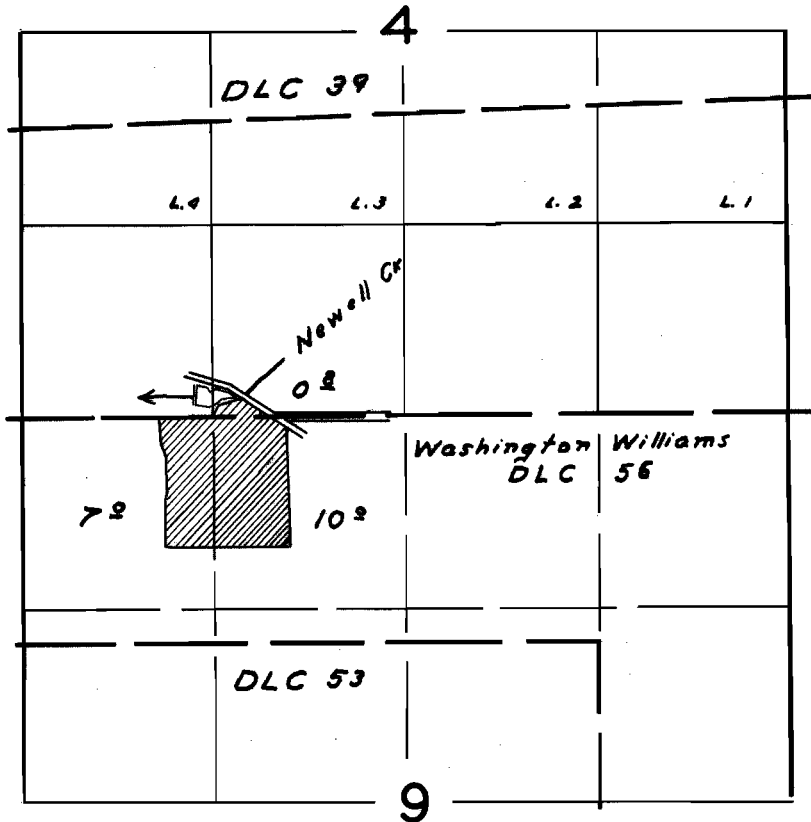

FINAL PROOF SURVEY
UNDER

Application No. R-31722 Permit No. R-2044
31723 25010
IN NAME OF

American Menconi

Surveyed July 1 1958, by W.N. Perry