


T. 3S. R. 2E. W.M.

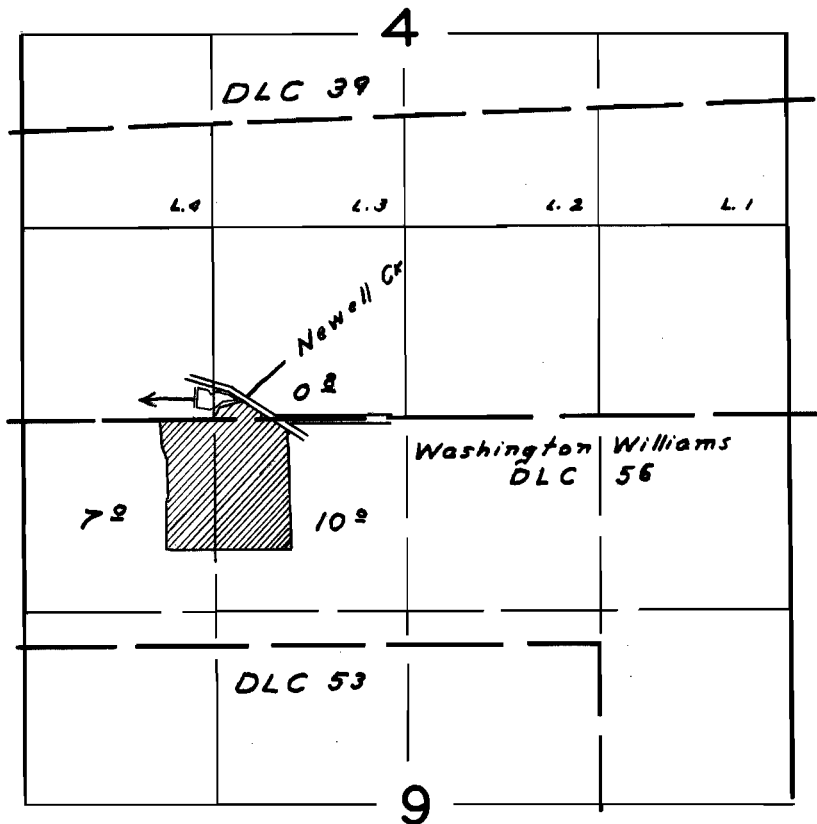

FINAL PROOF SURVEY
UNDER

Application No. R-31722 R-2044
31723 Permit No. 25010
IN NAME OF

American Menconi

Surveyed July 1 1958, by W.N. Perry