


T.34 S.R. I.W.W.M.

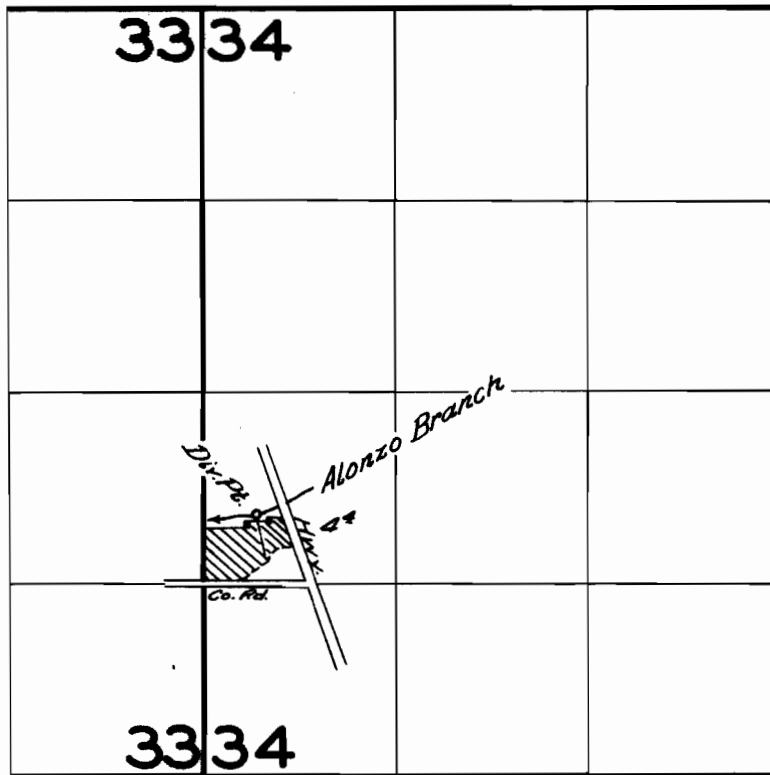

FINAL PROOF SURVEY
UNDER

Application No. 31892 .. Permit No. 25154 ..
IN NAME OF

..... *LEONARD BURDAHL*

Surveyed *May 5* .. 1959, by *C.O. Bartels* ..