


T. 20 S. R. 3 W. W.M.

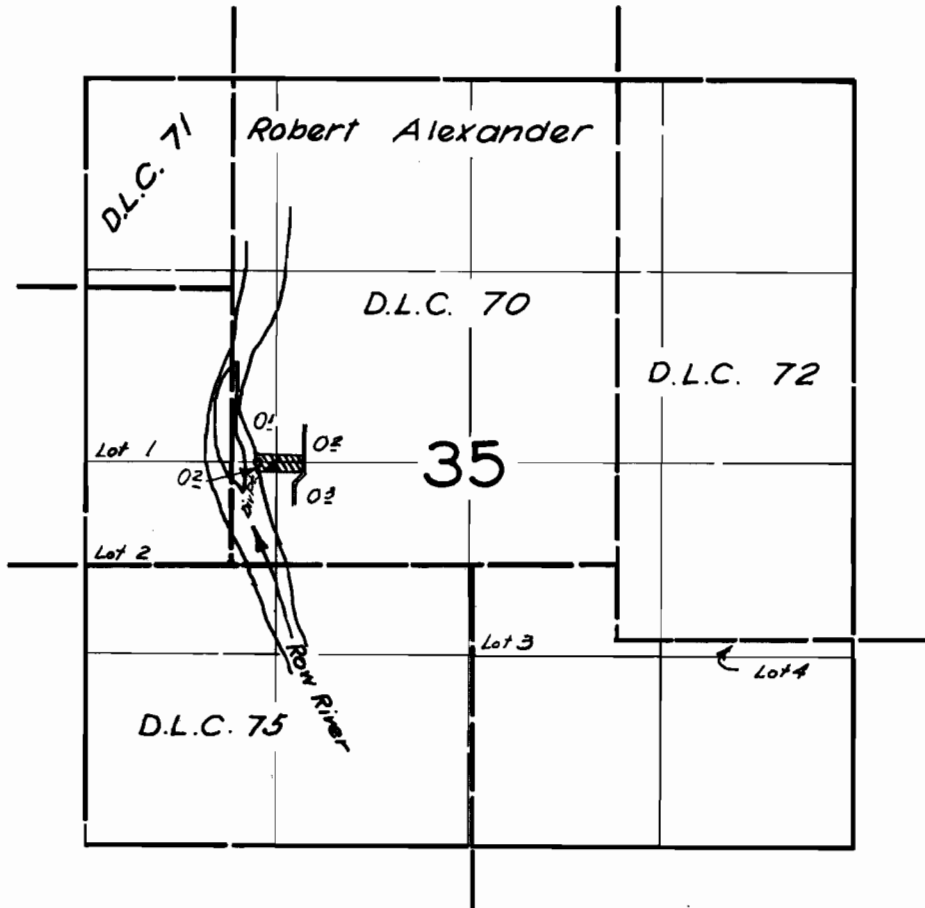

**FINAL PROOF SURVEY**  
UNDER

Application No. 31904... Permit No. 25204.  
IN NAME OF

*GUSTAVE A. & ALICE VICTORIA PIEL*

Surveyed 23 Mar. 1959, by *R. Jackson*