


T. 15S. R. 5W. W.M.

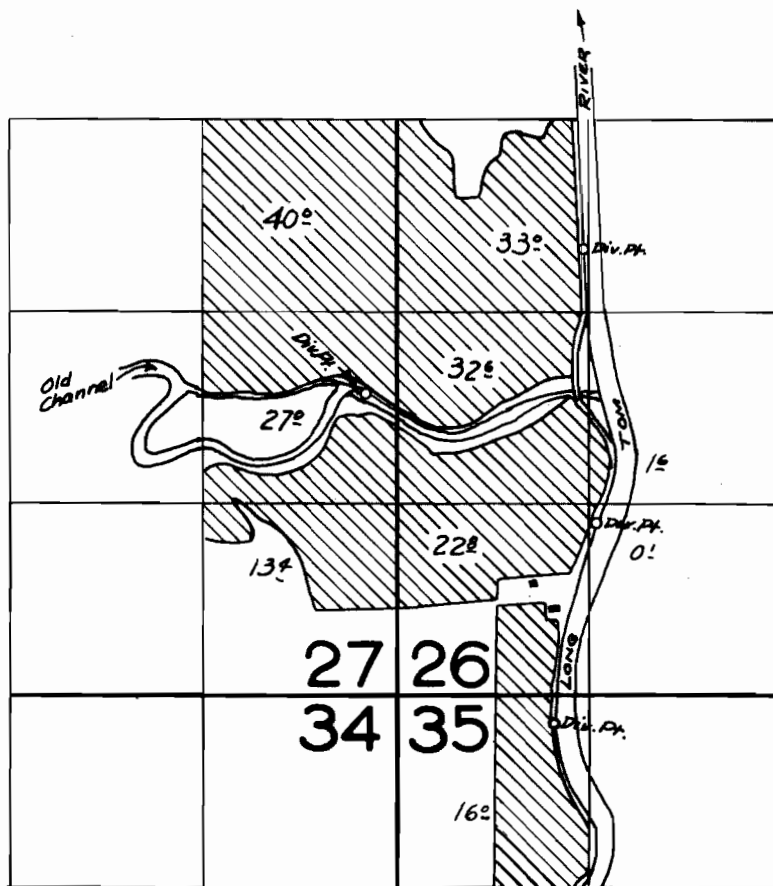

FINAL PROOF SURVEY
UNDER

Application No. 32070.. Permit No. 25322..
IN NAME OF

BROCKNER MIKKELSEN

Surveyed April 3.. 1959, by R. H. Jackson