




U-275  
26807

# T. 38 S. R. 11 1/2 E. W.M.

Swan Lake Weeds

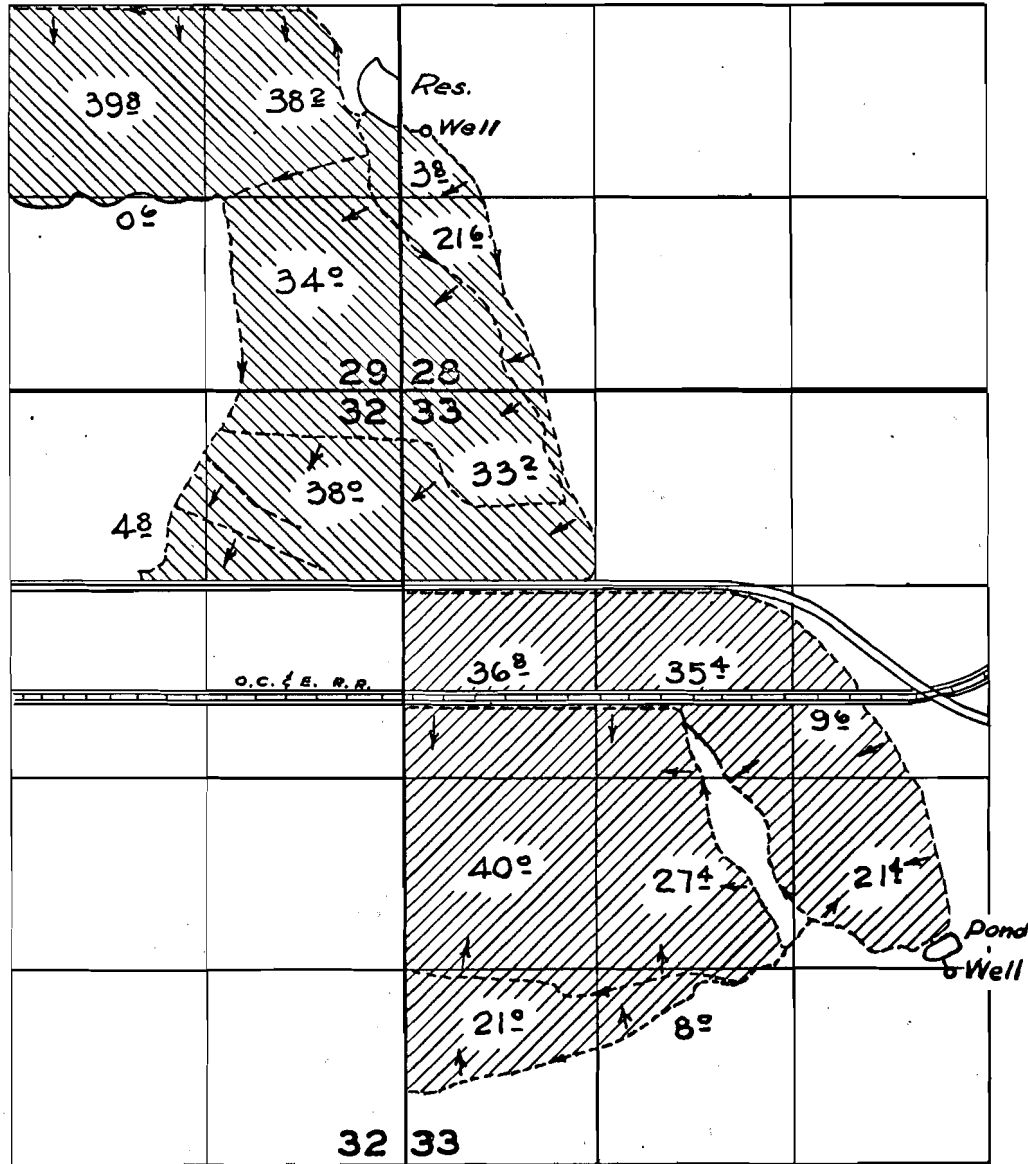

U-300   
 U-328 

## FINAL PROOF SURVEY UNDER

U-300                      U-275  
 Application No. U-328. Permit No. U-302..  
 IN NAME OF

**GUY BARTON**

Surveyed 6 May 1958, by C.O. Bartels.