



T.40 S.R.11 & 12 E.W.M.

West River wells

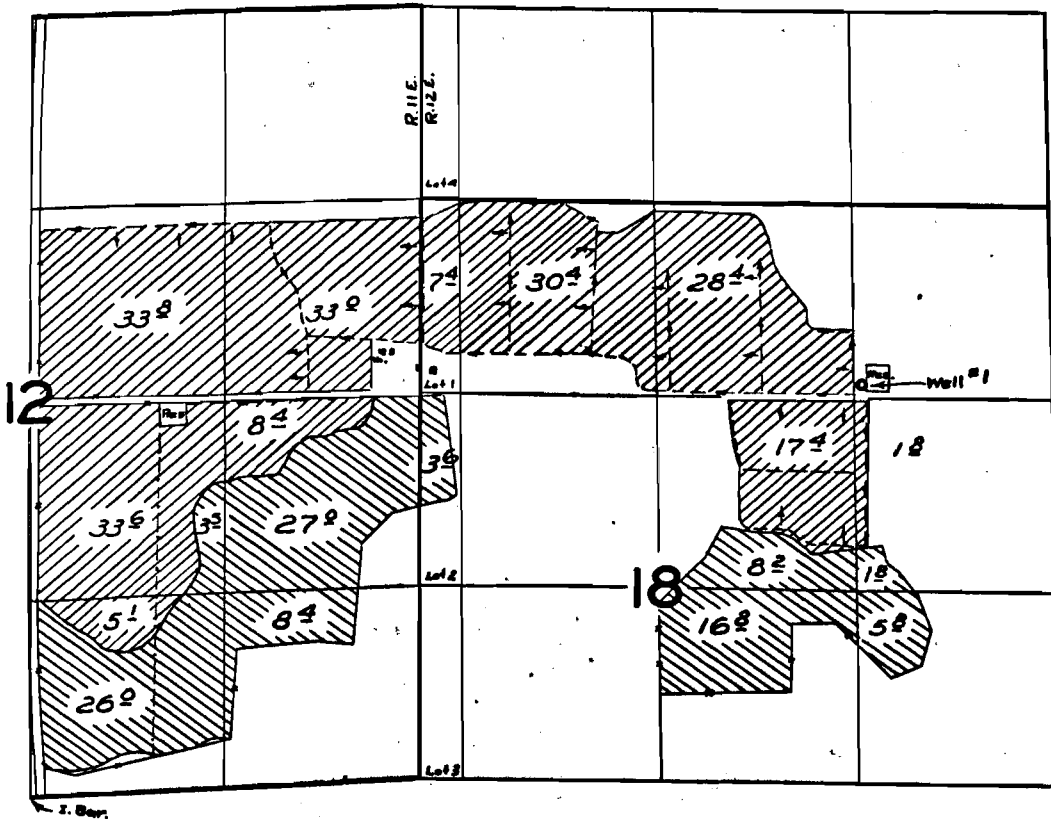

FINAL PROOF SURVEY

UNDER

Application No. U-326 ~~U-534~~ Permit No. U-301 ~~U-650~~ 

IN NAME OF

WILLIAM OR MILDRED J. RAJNUS

Surveyed 23 Oct. 1952, by T. Ber.