


T.40 S.R.11 & 12 E.W.M.

East River wells

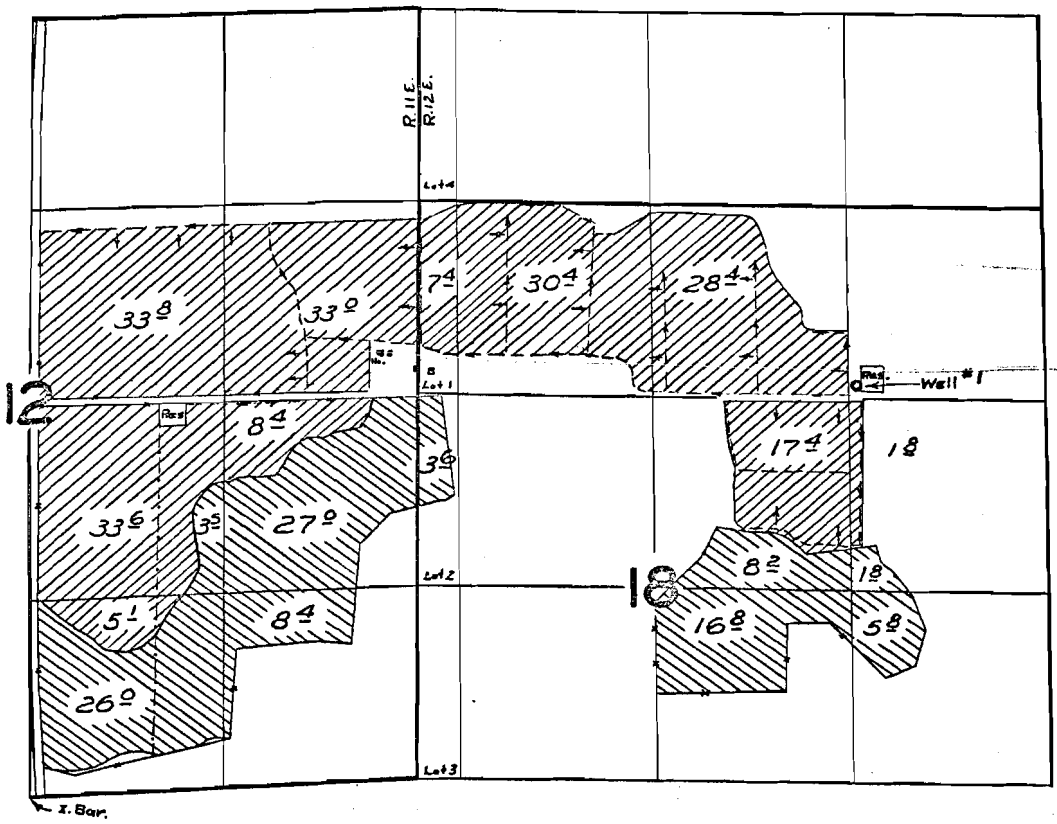

FINAL PROOF SURVEY

UNDER

Application No. U-326 U-534 Permit No. U-301 U-650

IN NAME OF

WILLIAM OR MILDRED J. RAJNUS

Surveyed 23 Oct. 19 59, by M. Bish