


T. 6 S. R. 39 E. W. M.

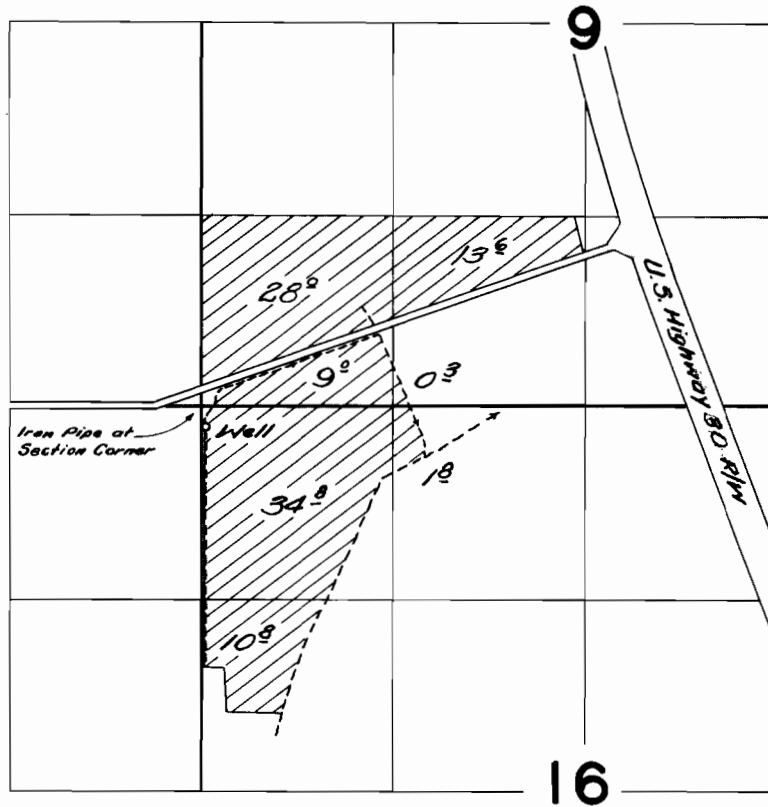

FINAL PROOF SURVEY
UNDER

Application No. *U-441* Permit No. *U-412*
IN NAME OF

A. S. Boyd

Surveyed *Aug. 12* 1959, by *W. B. Bartlett*