


T. 13S. R. 40 & 41E. W.M..

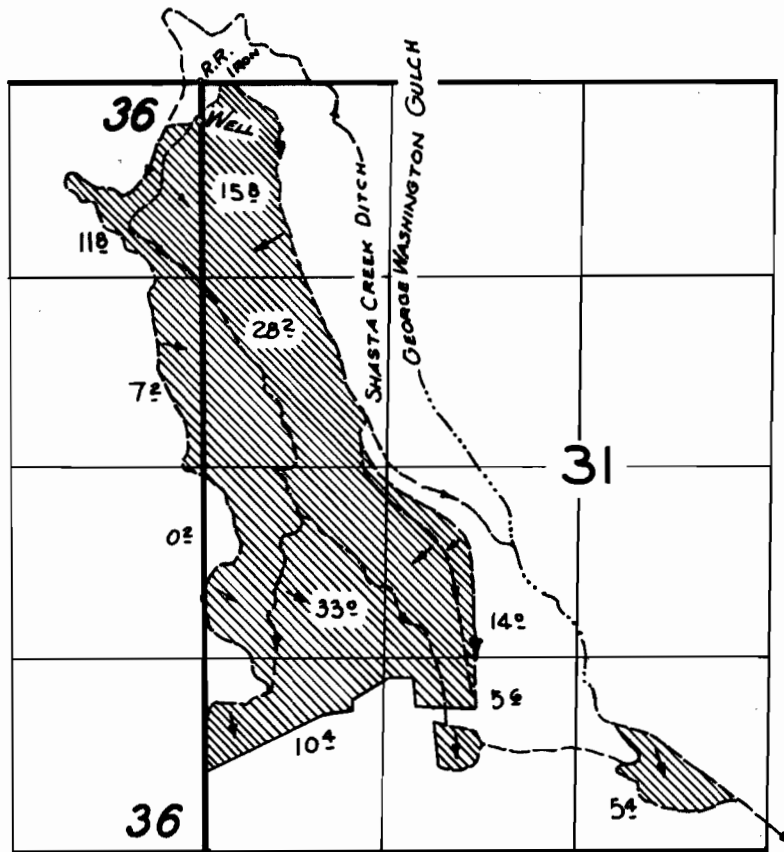

FINAL PROOF SURVEY
UNDER

Application No. U-539... Permit No. U-485...
IN NAME OF

CARROLL & SYLVIA LOCEY

Surveyed 27 Oct. 1959, by C.O. Bartels..