


T.38S. R.11E.W.M.

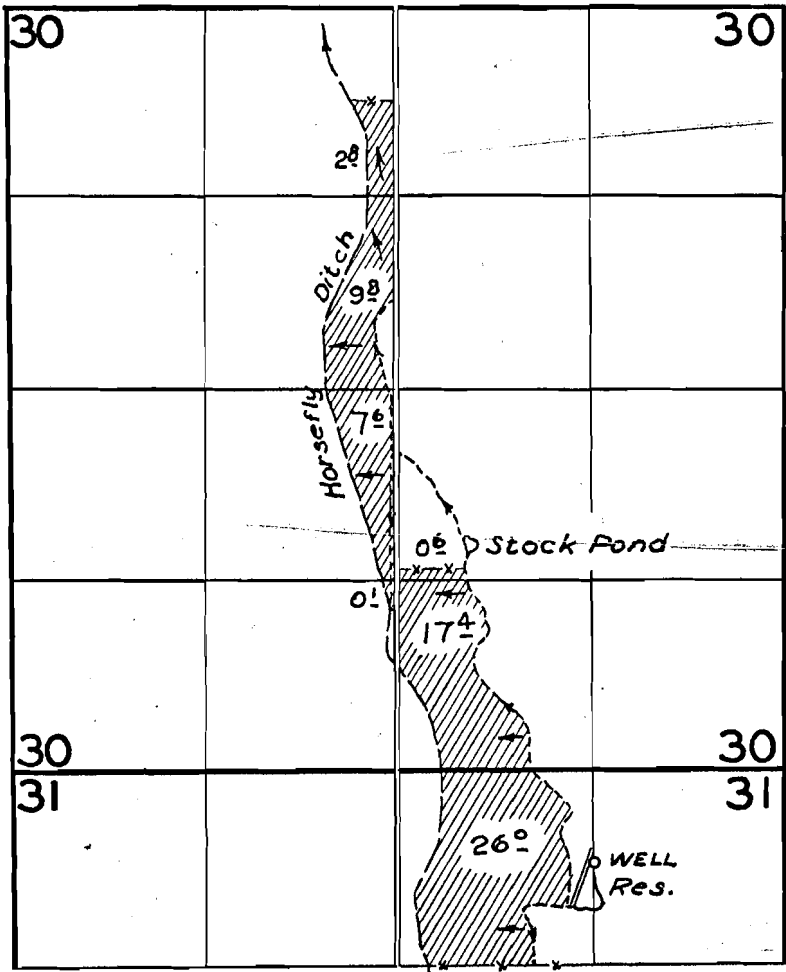

Buckle Creek & Yuma Valley wells

FINAL PROOF SURVEY UNDER

Application No. U-451... Permit No. U-540.

IN NAME OF

**J. LUTHER, NELLIE L.,
VICTOR LAVERNE, NORMA JEAN HASKINS**

Surveyed 28 April 1958, by C.O. Bartels