


T.3S. R.38E.W.M.

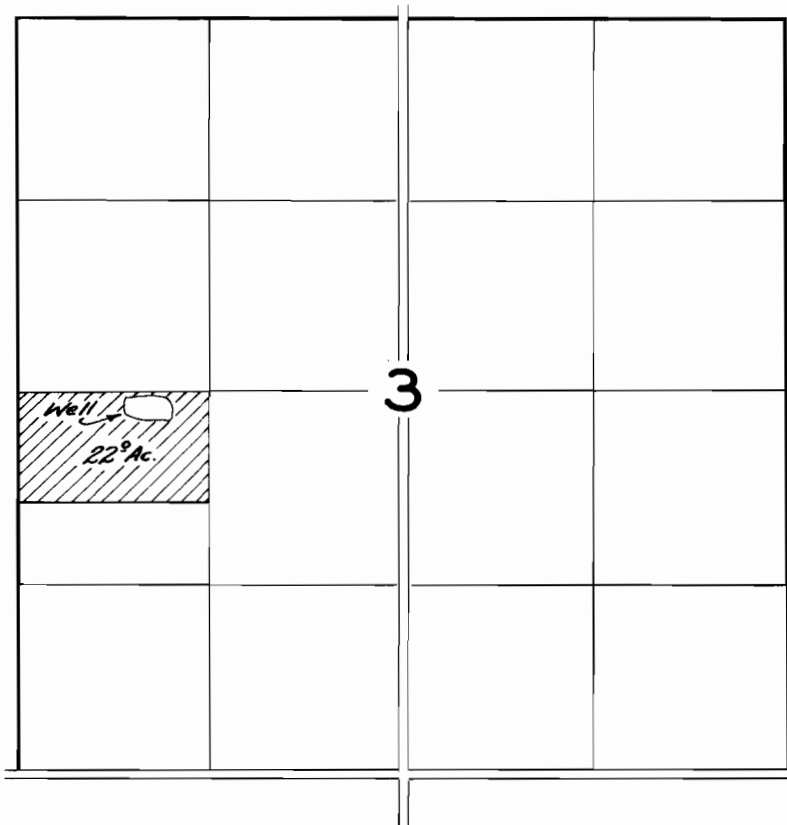

FINAL PROOF SURVEY
UNDER

Application No. *U-753* ... Permit No. *U-684* ...
IN NAME OF

Roy R. & Leola M. Leonard

Surveyed *Aug. 5* ... 19*59* by *C.D. Bartels*