


T.41 S.R.10 E.W.M.

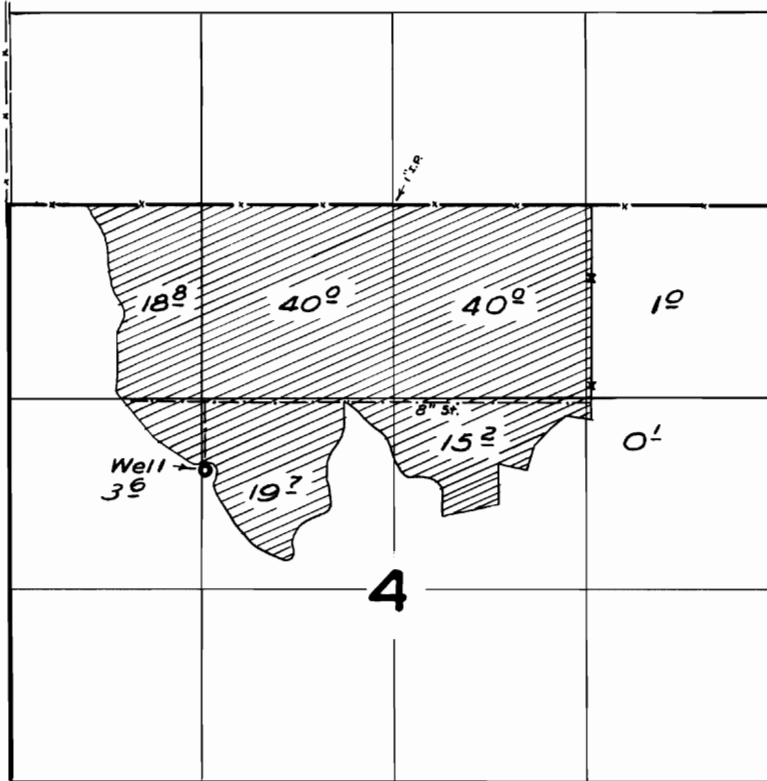

FINAL FLOOR SURVEY

1959

Application No. G-15 - Part No. G-63

in FAVOR OF

MARION J. BARNES

Surveyed 27 Oct. 19 59 by M. B. Bish

CNO-61K-30