


T. 4 S. R. 39 E. W.M.

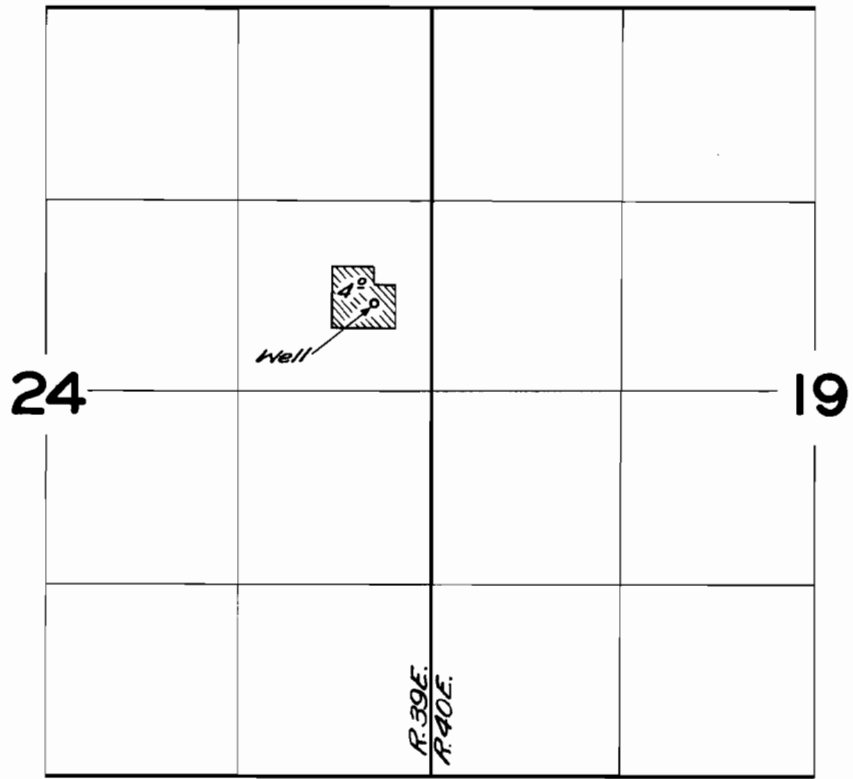

FINAL PROOF SURVEY
UNDER

Application No. *G-336* Permit No. *G-241*
IN NAME OF

Lloyd A. & Belle Depew

Surveyed *Aug. 11*, 1959, by *C.O. Baeth*