


T.15S.R.4 W.W.M.

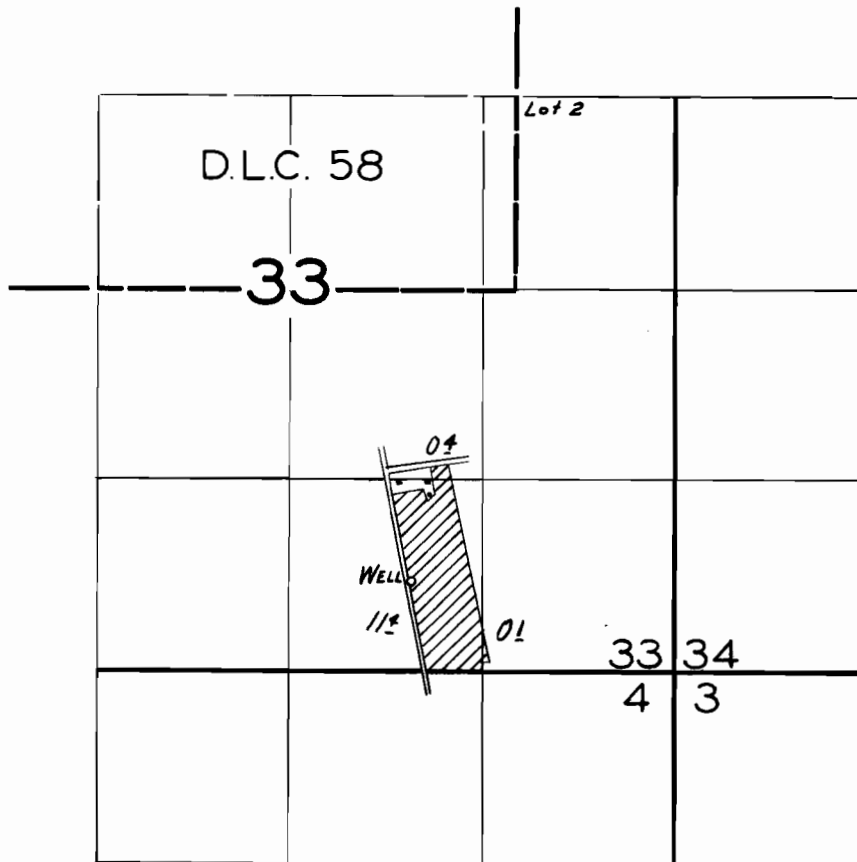

FINAL PROOF SURVEY
UNDER

Application No. G-349. Permit No. G-418.
IN NAME OF

JOEN N. BODTKER

Surveyed *April 3*, 1959, by *R. Jackson*