


T.15 S. R. 4 W. W.M.

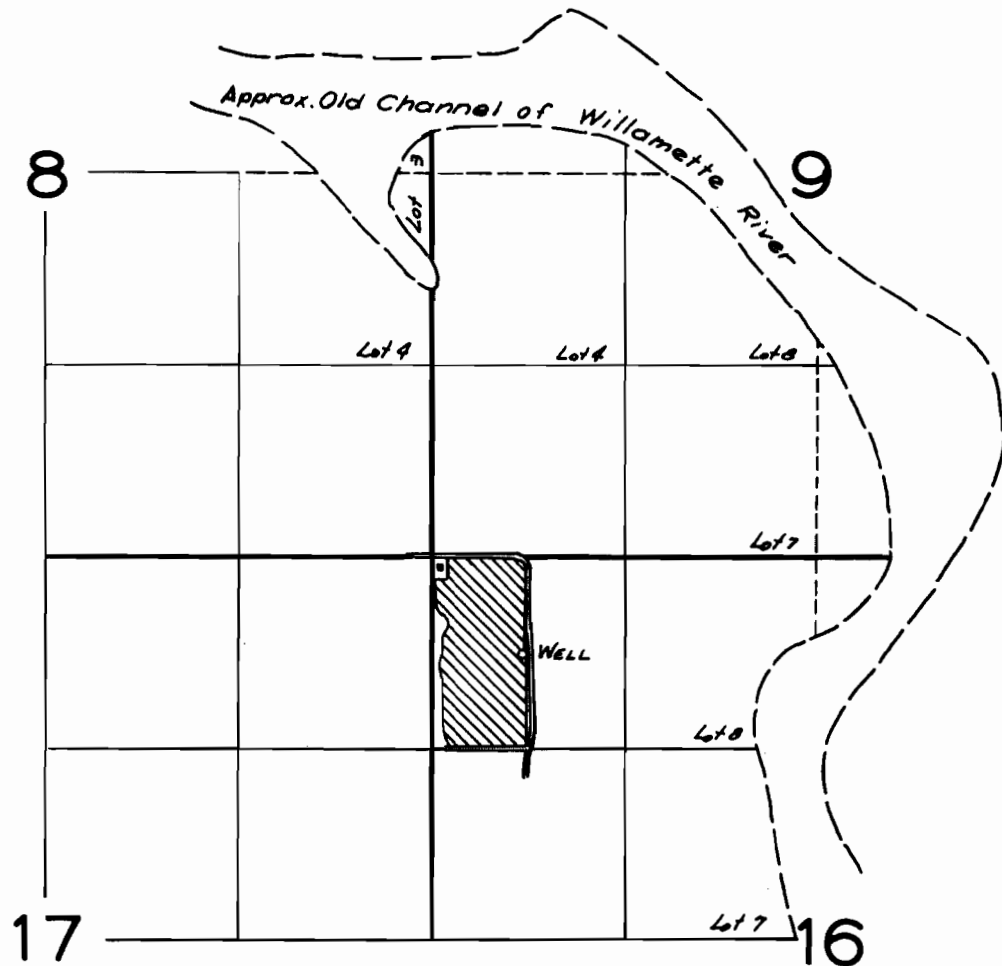

**FINAL PROOF SURVEY**  
UNDER

Application No. *G-600*. Permit No. *G-503*  
IN NAME OF

*Roy C. & Rachel Betterton*

Surveyed *April 1*, 1959, by *R. Jackson*