


T.17S. R. 3 W.W.M.

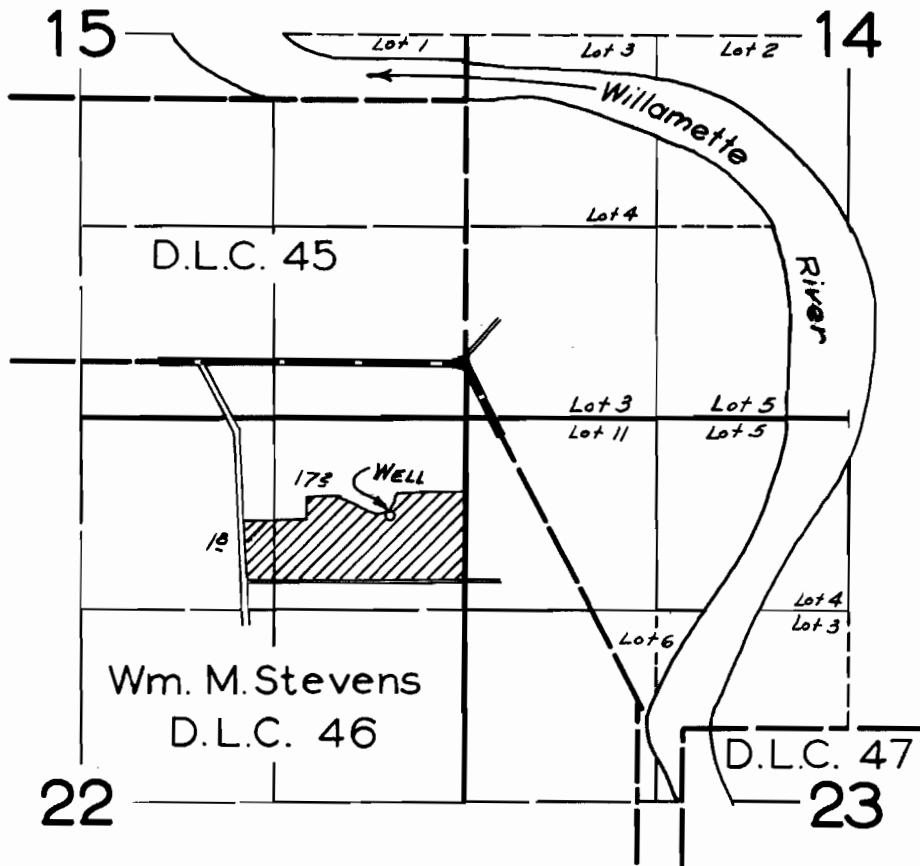

FINAL PROOF SURVEY
UNDER

Application No. G-648... Permit No. G-546...
IN NAME OF

EDSEL W. CHASE

Surveyed April 1, 1959, by *D. Jackson*