


T. 6S. R. 3W. W.M.

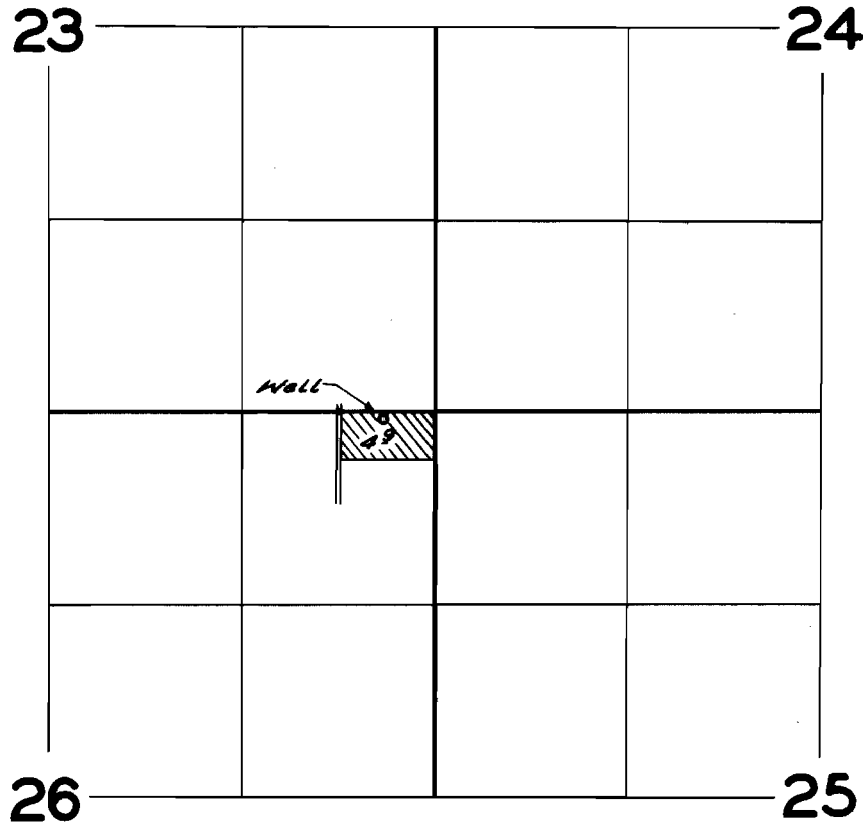

FINAL PROOF SURVEY
UNDER

Application No. *G-954* Permit No. *G-814*
IN NAME OF

Wilm. G. Peterson

Surveyed *May 25* 1959, by *C.O. Burtels*