


T.17S. R.3W.W.M.

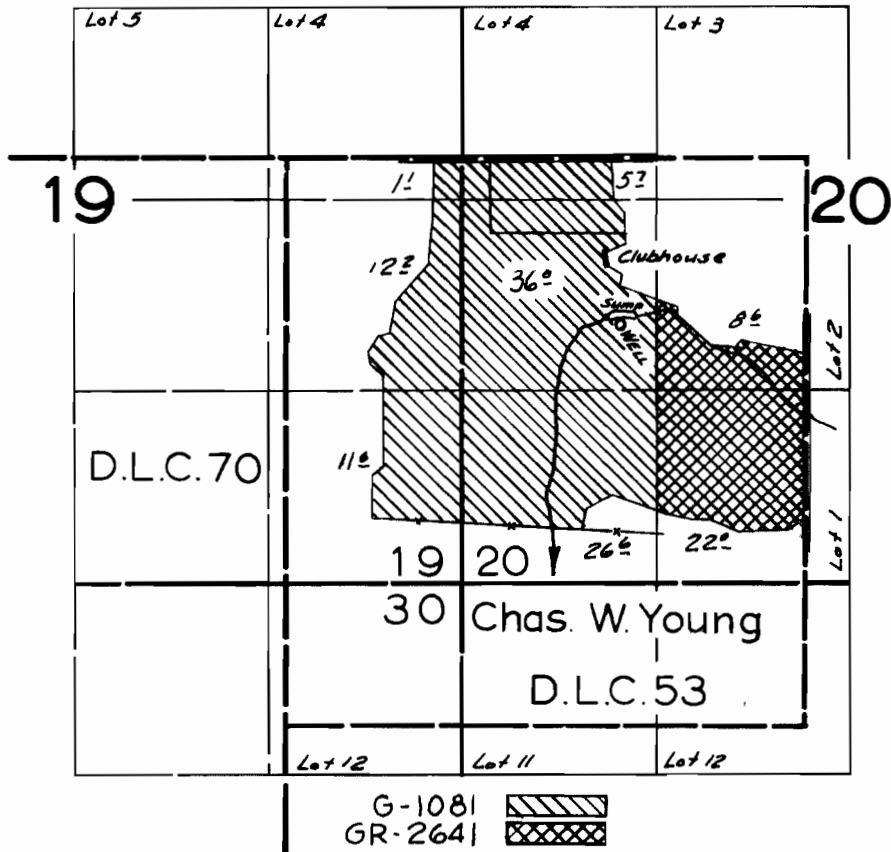

FINAL PROOF SURVEY
UNDER

Application No. G-1081 Permit No. G-978
IN NAME OF

OAKWAY GOLF COURSE

Surveyed April 2, 1959, by R. H. Jackson