


T. 11 S. R. 4 W. W. M.

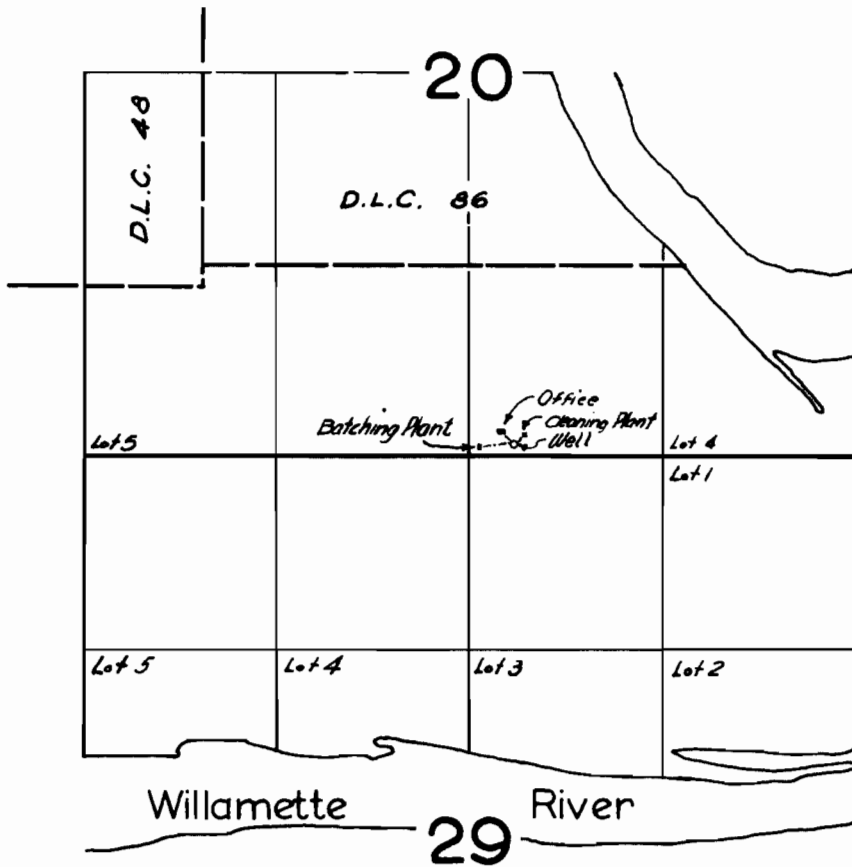

FINAL PROOF SURVEY
UNDER

Application No. *G-1183* Permit No. *G-1057*
IN NAME OF

JOHN T. CONSER

Surveyed *10 March 1959* by *R.H. Jackson*