


20823

T.38S. R.25E.W.M.

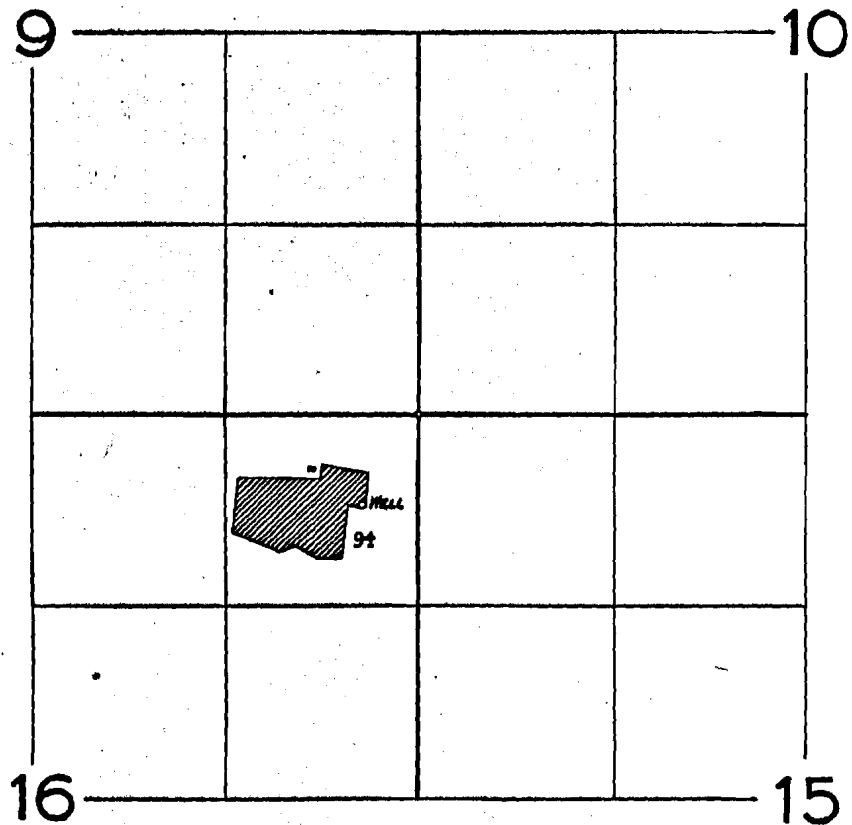

FINAL PROOF SURVEY UNDER

Application No. G-1015... Permit No. G-10.91...
IN NAME OF

BILL COX

Surveyed May 8, 1959, by *D. Jackson*