


T. 1 N. R. 3 W. W. M.

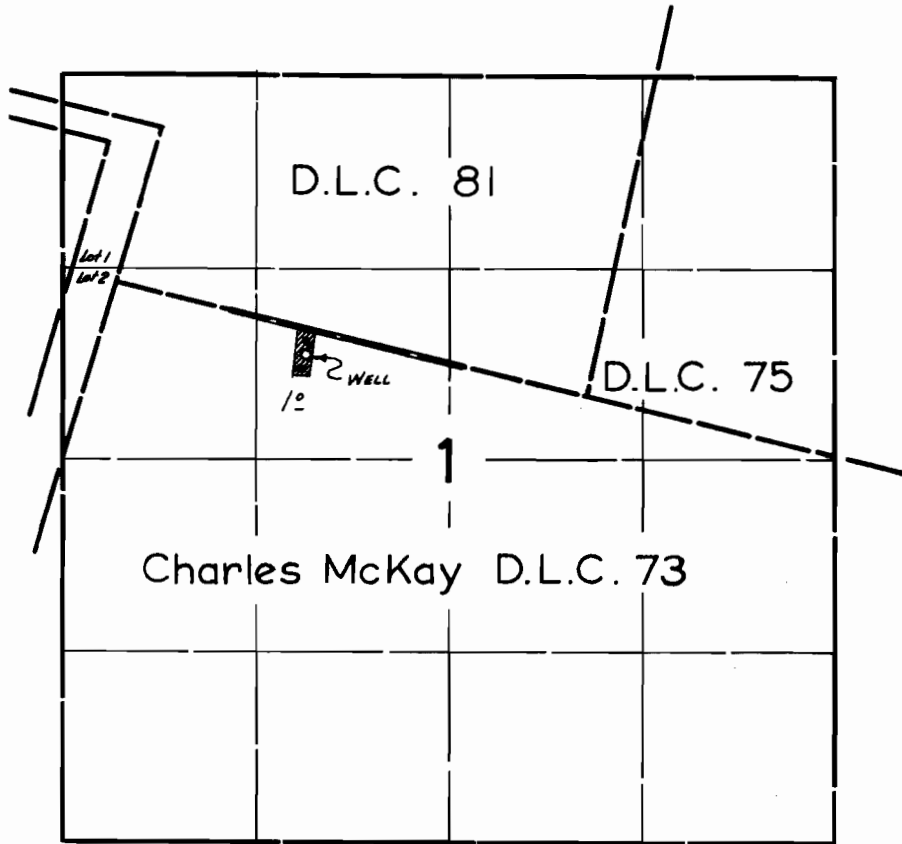

**FINAL PROOF SURVEY**  
UNDER

Application No. *G-1306*... Permit No. *G-1187*...  
IN NAME OF

**HENRY & GLADYS DEVLAEMINCK**

Surveyed *June* 1959, by *R. Jackson*