


T.2S.R.38E.W.M.

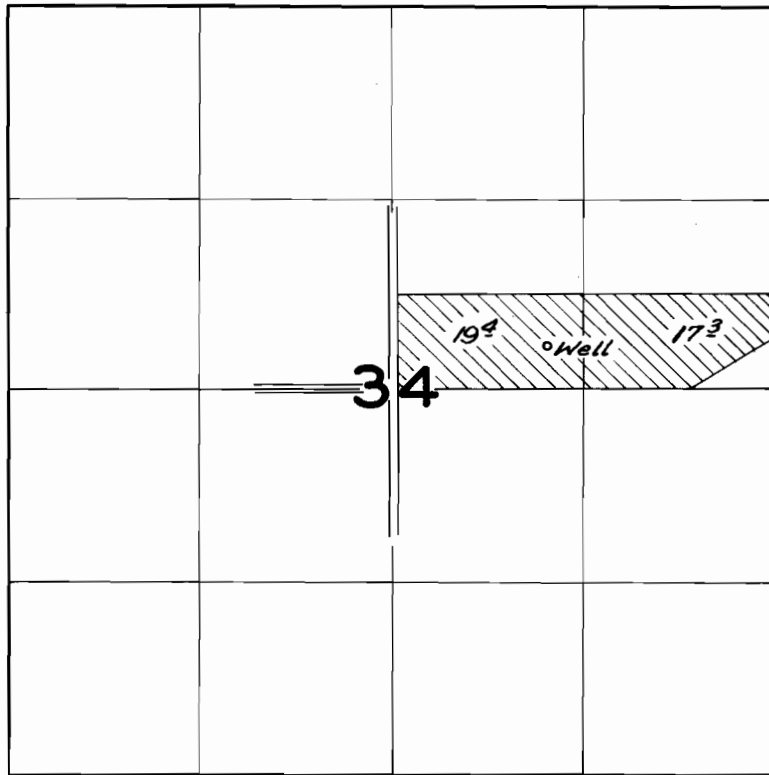

**FINAL PROOF SURVEY**  
UNDER

Application No. *G-1312* Permit No. *G-1203*  
IN NAME OF

*Claude E. Wright*

Surveyed *Aug. 4* 19*59*, by *C.O. Butts*