


T. 12 S. R. 8 W. W. M.

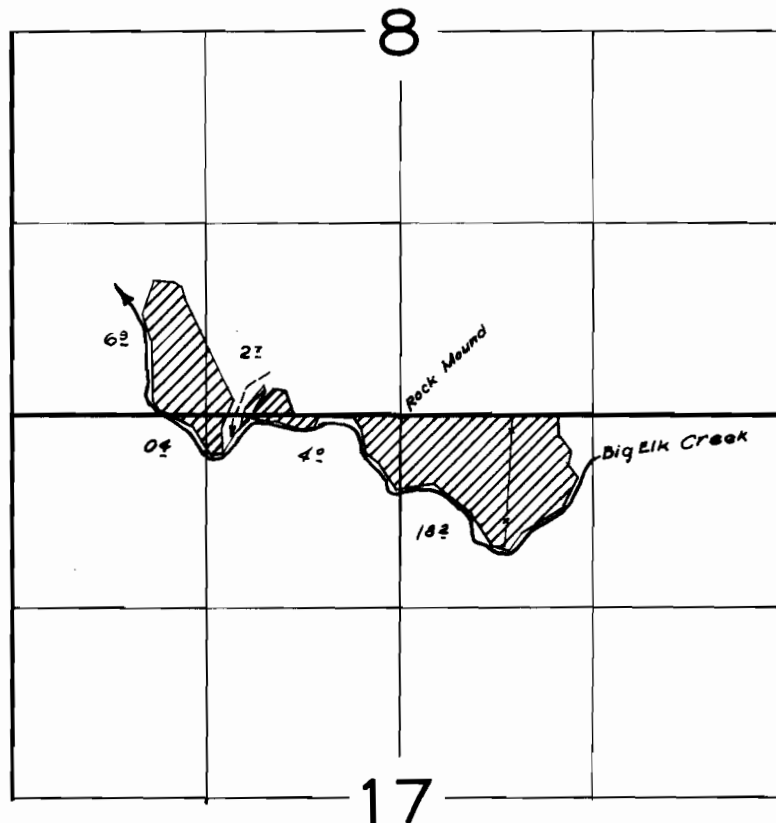

FINAL PROOF SURVEY
UNDER

Application No. 17.866... Permit No. 13560
IN NAME OF

C. E. SHEFFIELD

Surveyed 28 April, 1959, by *R. H. Jackson*