


T.38&39S. R.35E.W.M.

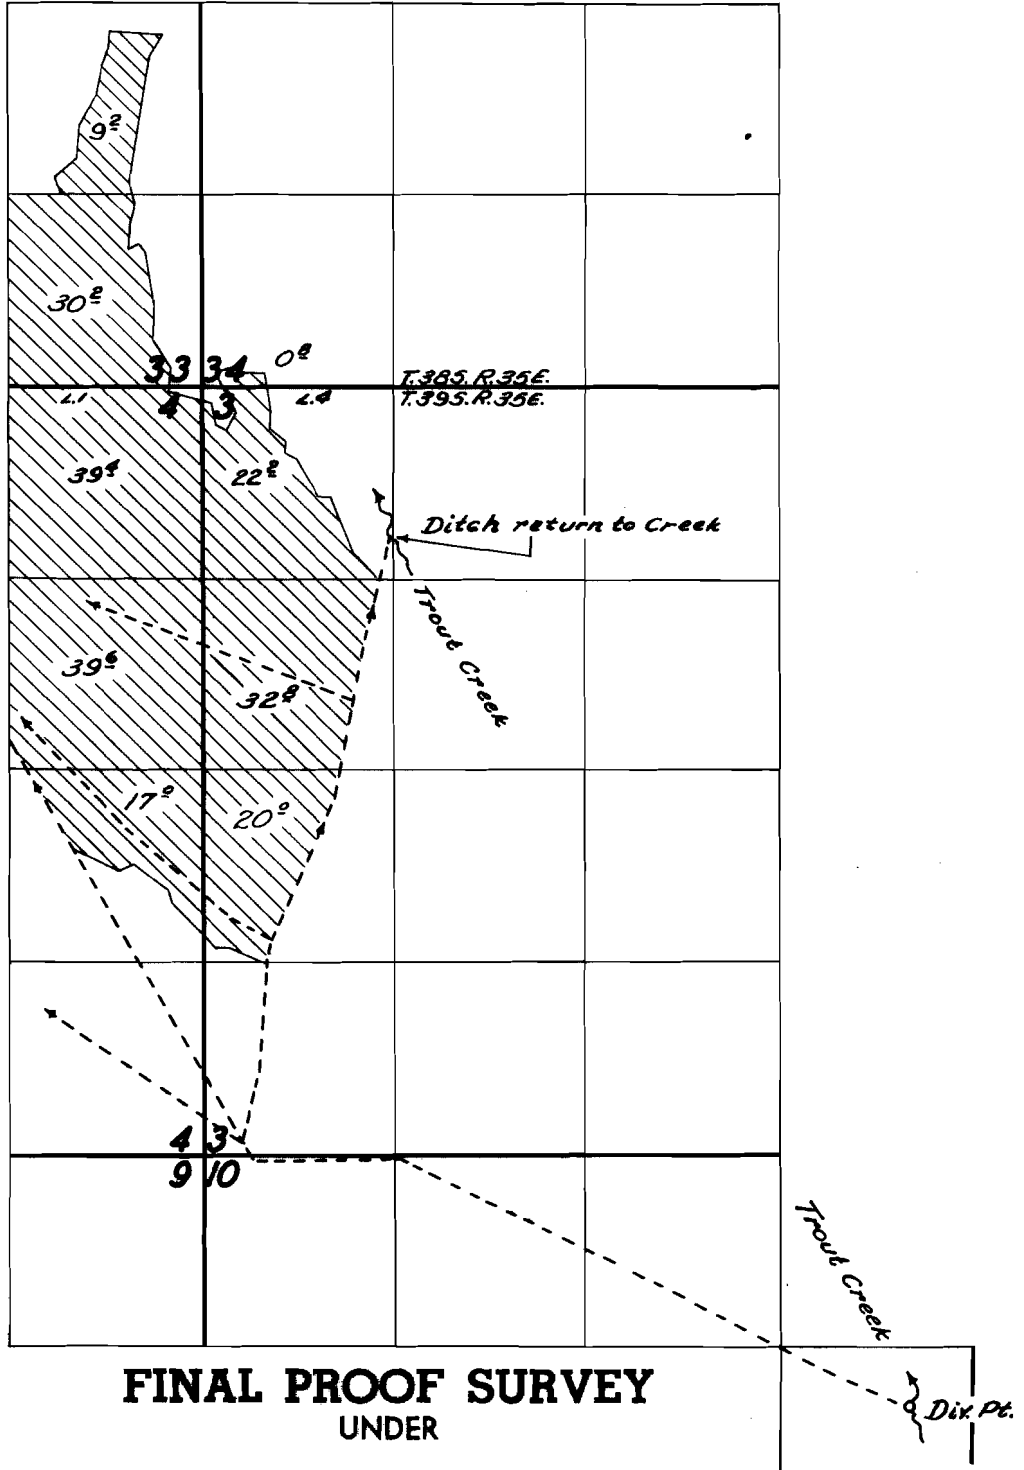

FINAL PROOF SURVEY
UNDER

Application No. 20602. Permit No. 16098
IN NAME OF

.....Warren McLean.....

Surveyed July 28, 1958, by C.O. Burtch.....