


# T.10S. R.13E.W.M.

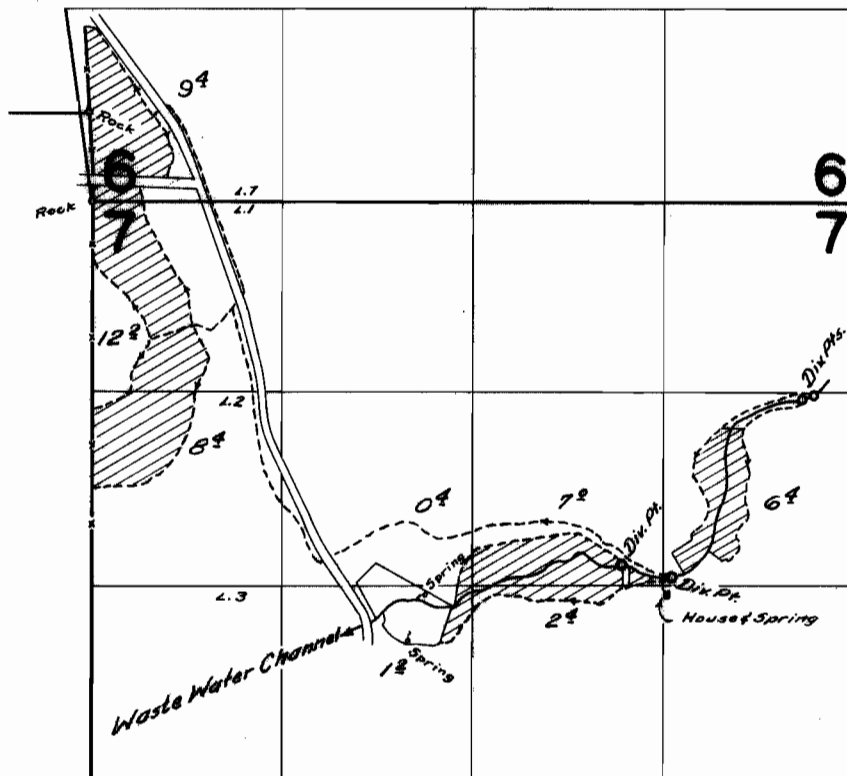

## FINAL PROOF SURVEY UNDER

Application No. 22509.. Permit No. 17739..  
IN NAME OF

.....*John L. Campbell*.....

Surveyed *June 20 1959*, by *C. Bartels*.....