



T. 23S. R. 27E. W.M.

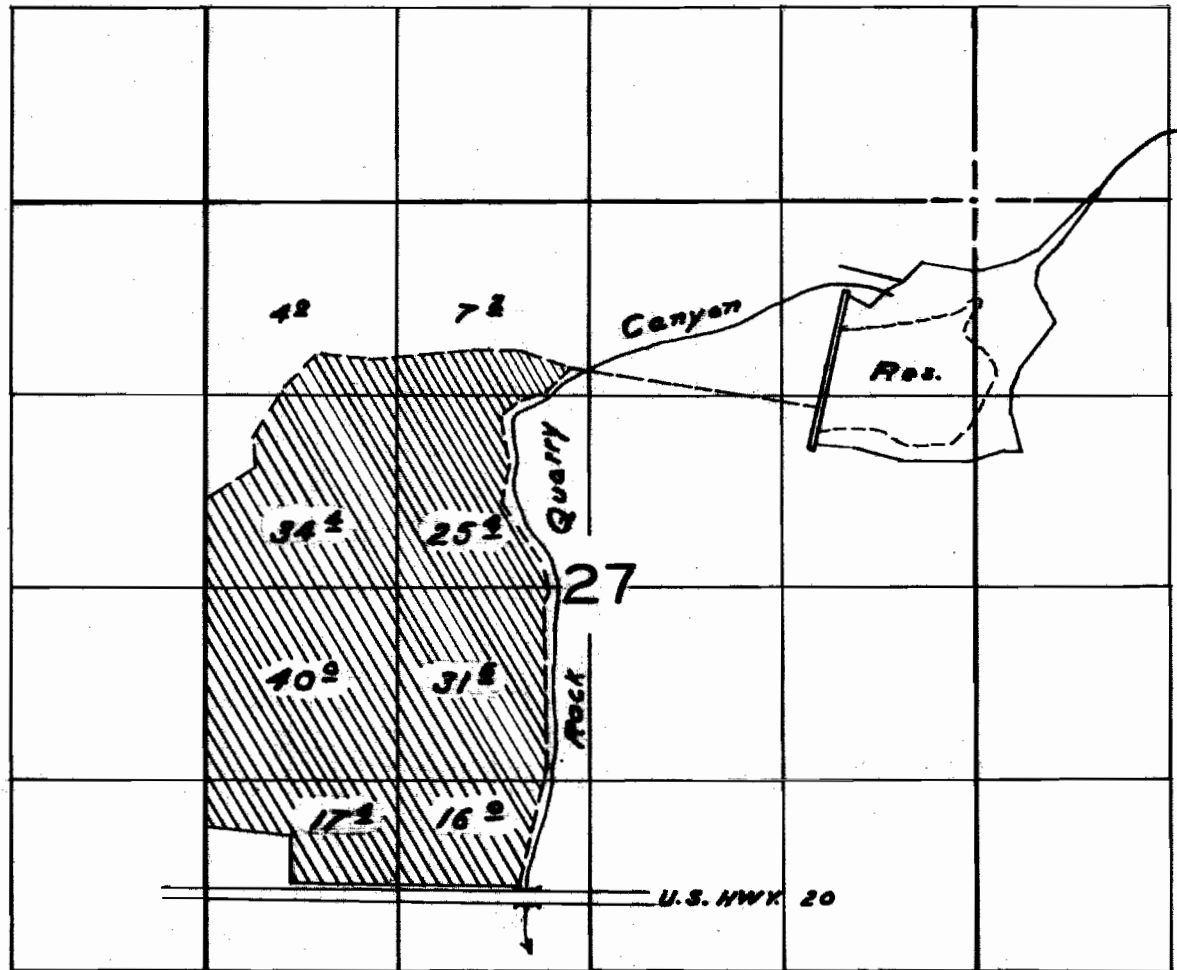

T. 23S. R. 27 & 28E. W.M.

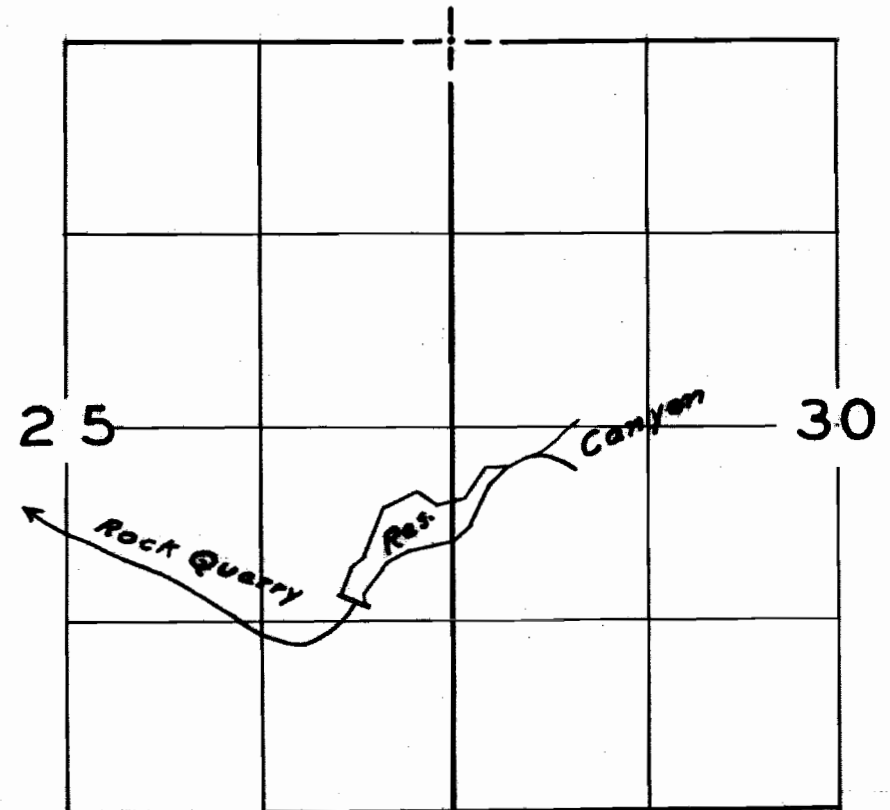

FINAL PROOF SURVEY  
UNDER  
APPL. NO. R-22771 PERMIT NO. R-899  
22772 17900  
R-22980 R-936  
22981 18281

IN NAME OF  
B.B. LAND COMPANY, INC.  
SURVEYED SEPT. 23 1958 BY W.N. PERRY