



T. 23 S. R. 27 E. W.M.

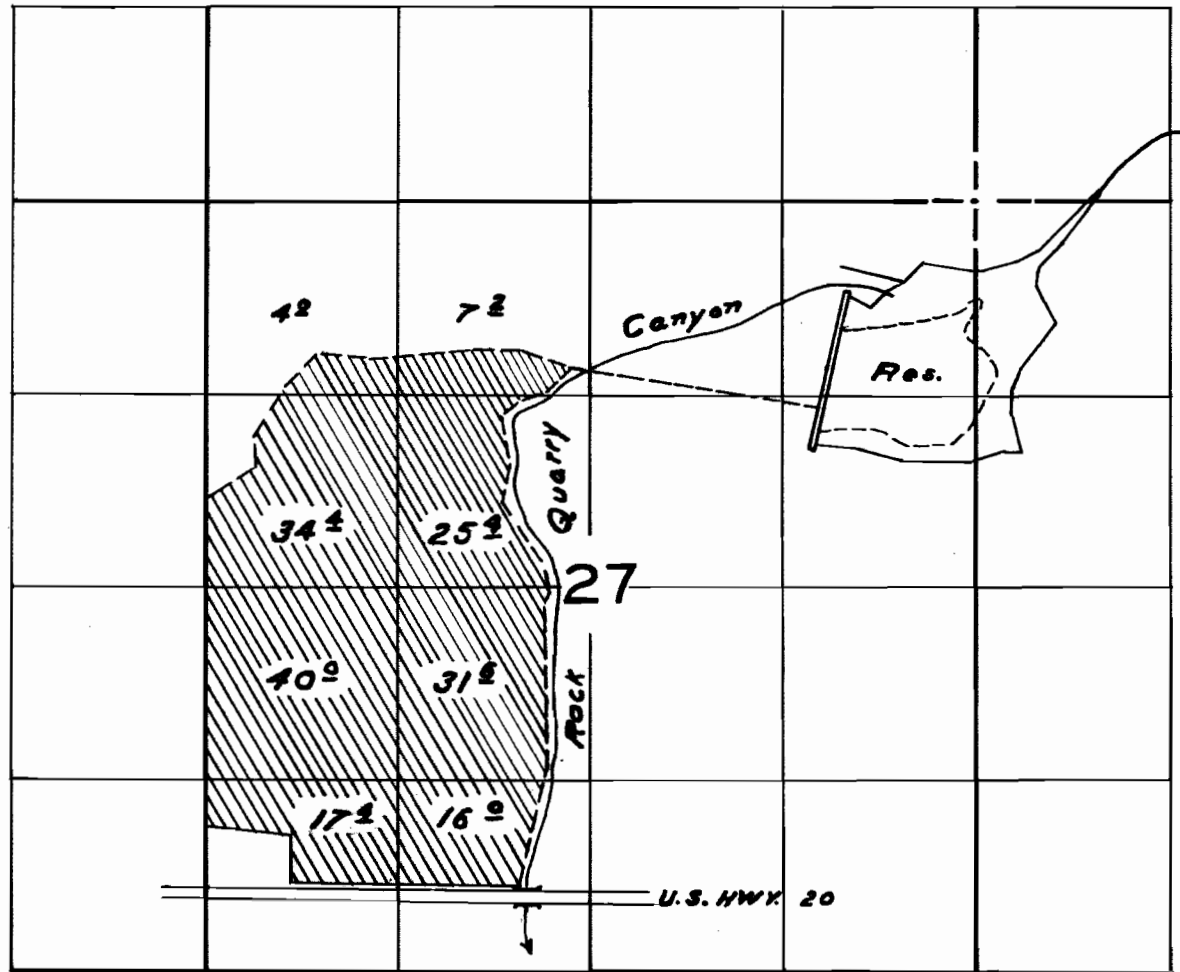

T. 23 S. R. 27 & 28 E. W.M.

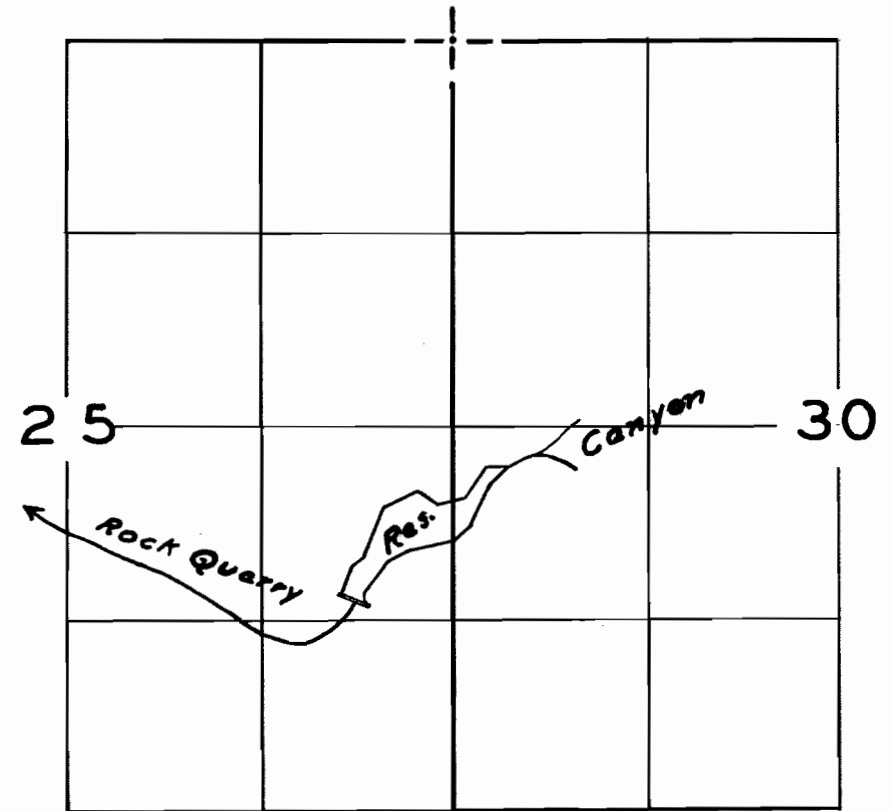

FINAL PROOF SURVEY
 UNDER
 APPL. NO. R-22771 PERMIT NO. R-899
 22772 17900
 R-22980 R-936
 22981 18281

IN NAME OF

B. B. LAND COMPANY, INC.
 SURVEYED SEPT. 23 1958 BY W. N. PERRY