



T. 23 S. R. 27 E. W.M.

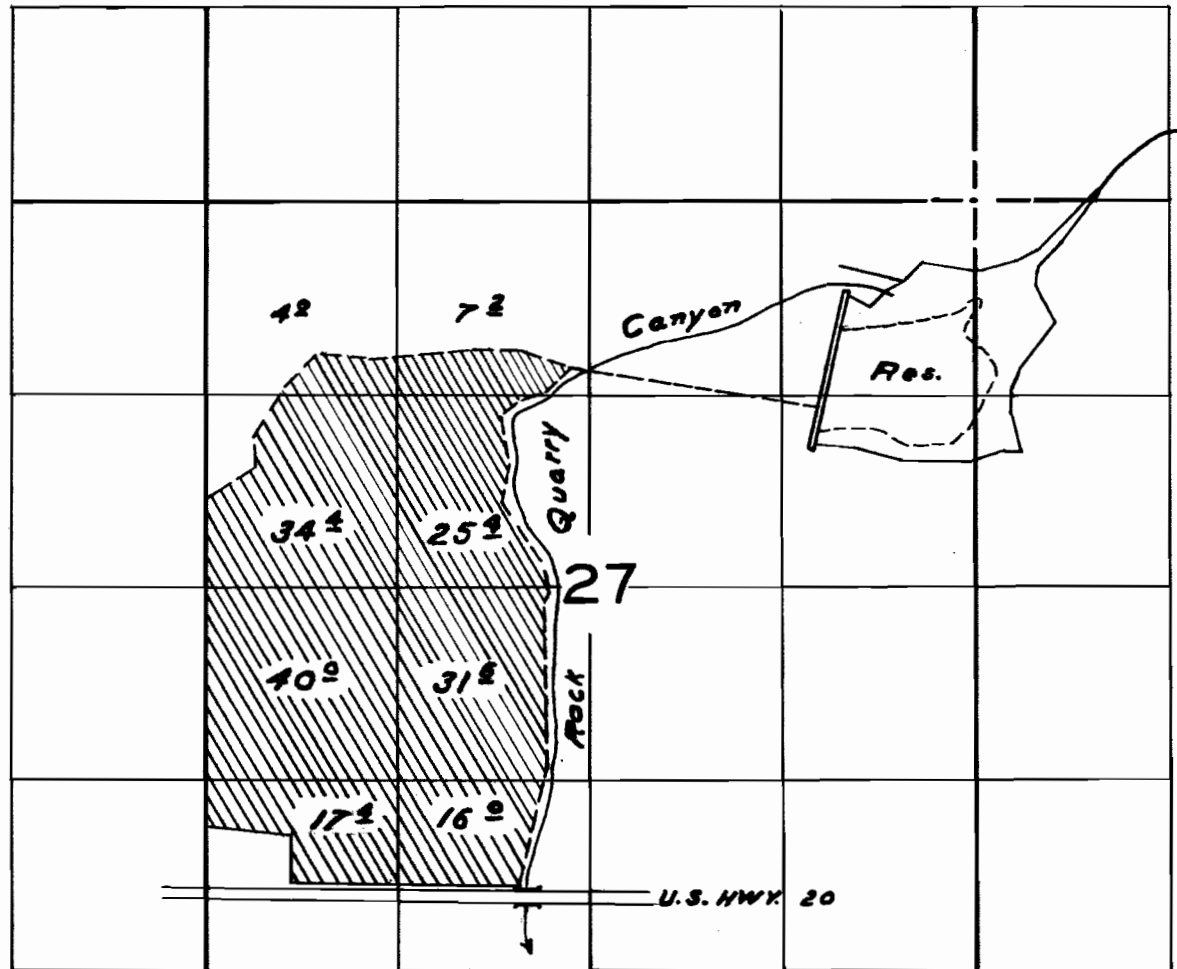

T. 23 S. R. 27 & 28 E. W.M.

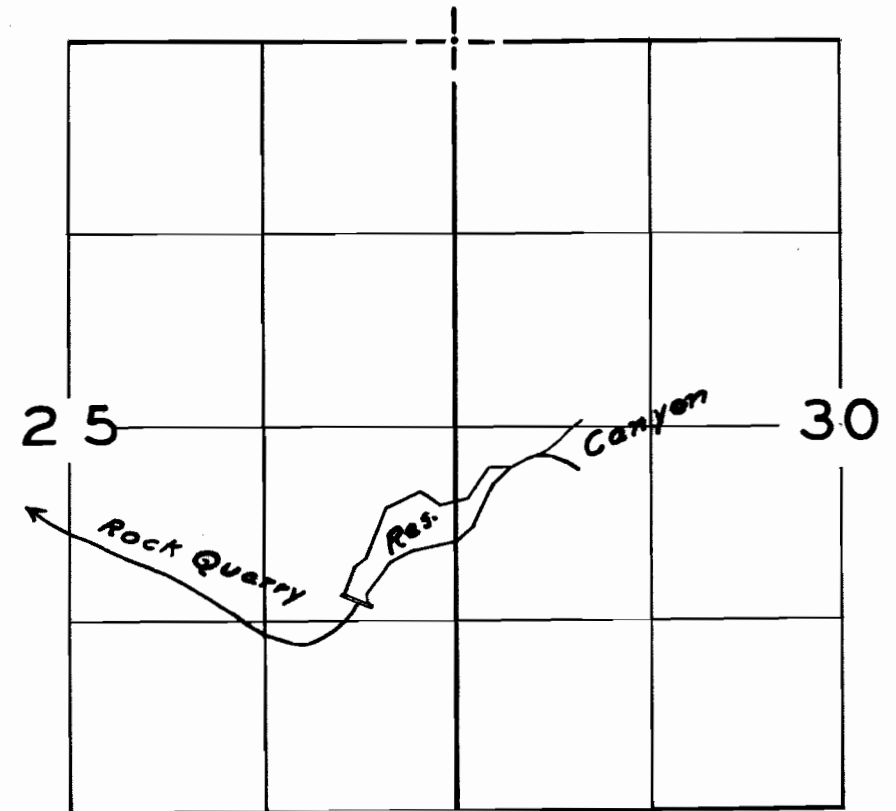

FINAL PROOF SURVEY
UNDER
APPL. NO. R-22771 PERMIT NO. R-899
22772 17900
R-22980 R-936
22981 18281

IN NAME OF

B.B. LAND COMPANY, INC.
SURVEYED SEPT. 23 1958 BY W.N. PERRY