



T. 23 S. R. 27 E. W.M.

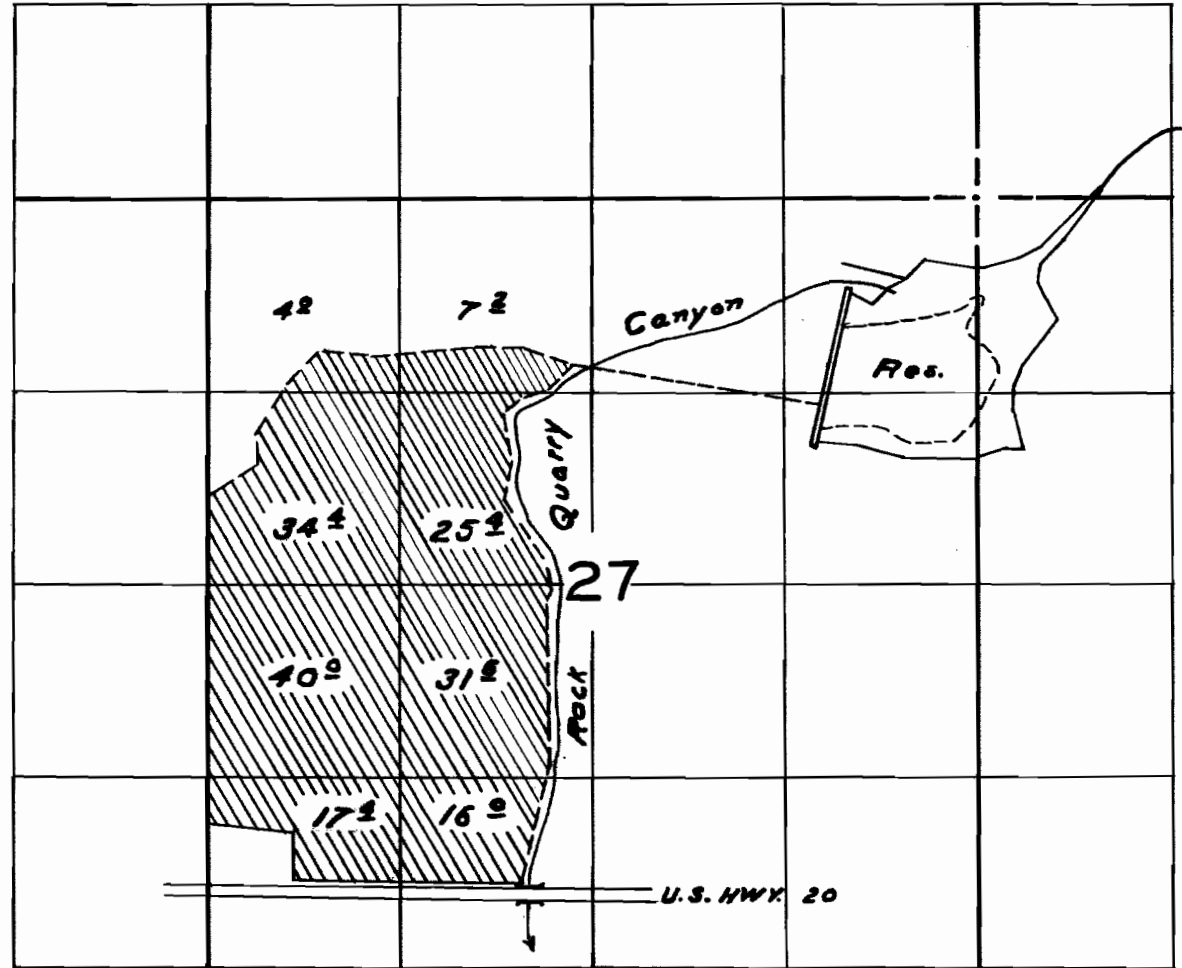

T. 23 S. R. 27 & 28 E. W.M.

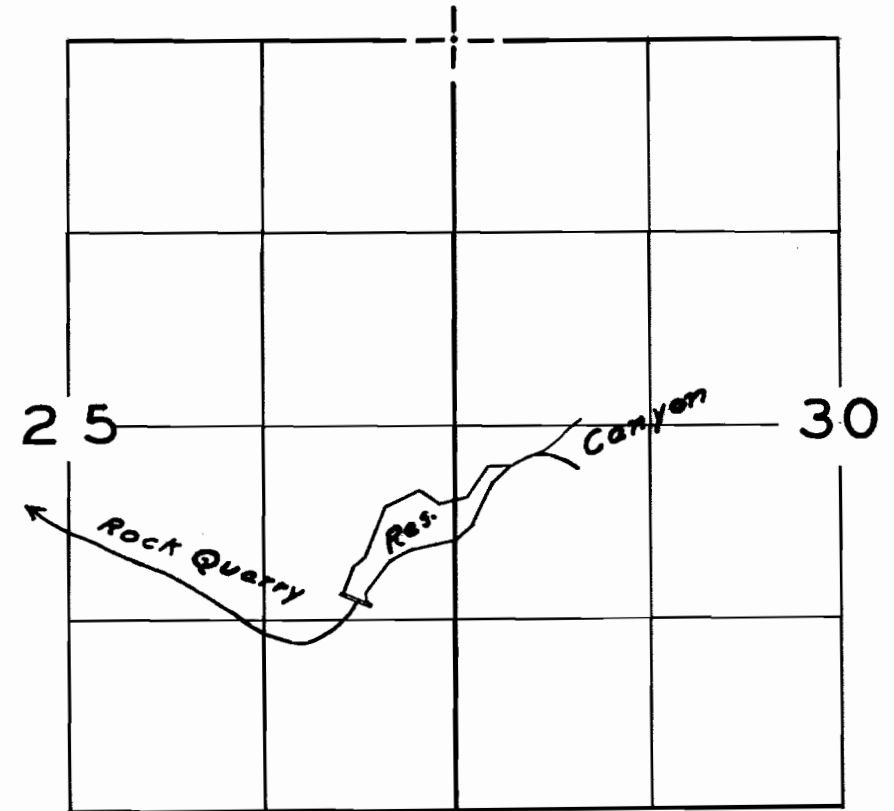

FINAL PROOF SURVEY

UNDER

APPL. NO. R-22771 PERMIT NO. R-899

22772

17900

R-22980

R-936

22981

18281

IN NAME OF

B.B. LAND COMPANY, INC.

SURVEYED SEPT. 23 1958 BY W.N. PERRY