


T. 2S. R. 38E.W.M.

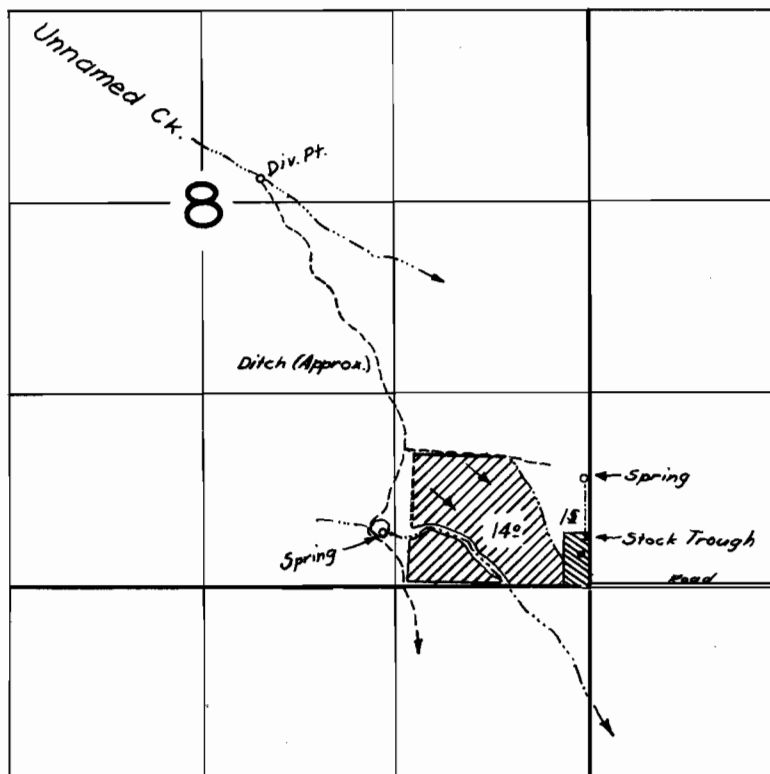

FINAL PROOF SURVEY
UNDER

Application No. 23255 Permit No. 18355
IN NAME OF

GLENN & MARIE LESTER

Surveyed August 15 1959, by R. H. Jackson