


T.9S.R.21E.W.M.

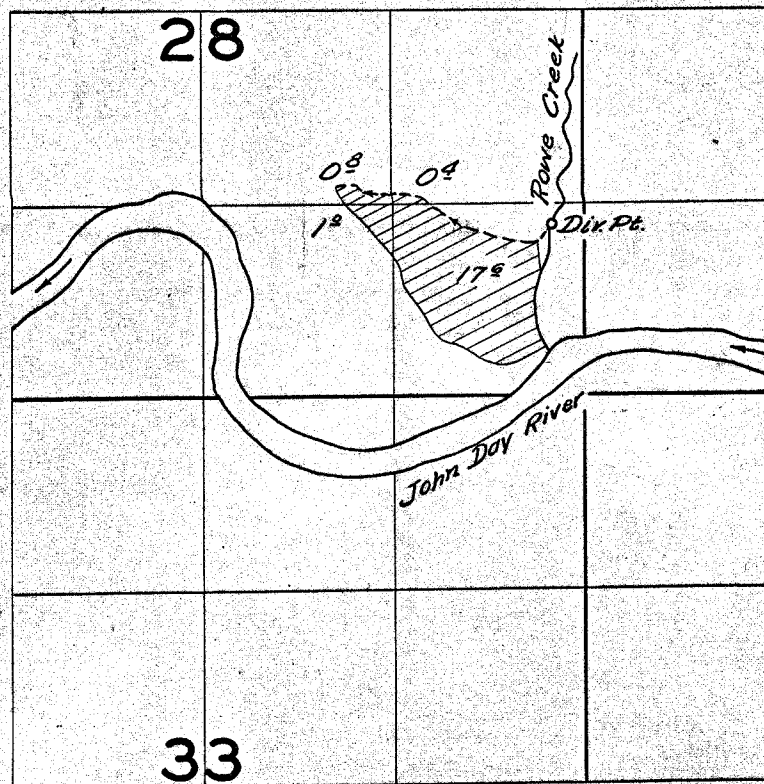

FINAL PROOF SURVEY
UNDER

Application No. 23527. Permit No. 19090...
IN NAME OF

.....
Surveyed June 23 1959, by C. O. Brutto.