


T.9S. R.21E.W.M.

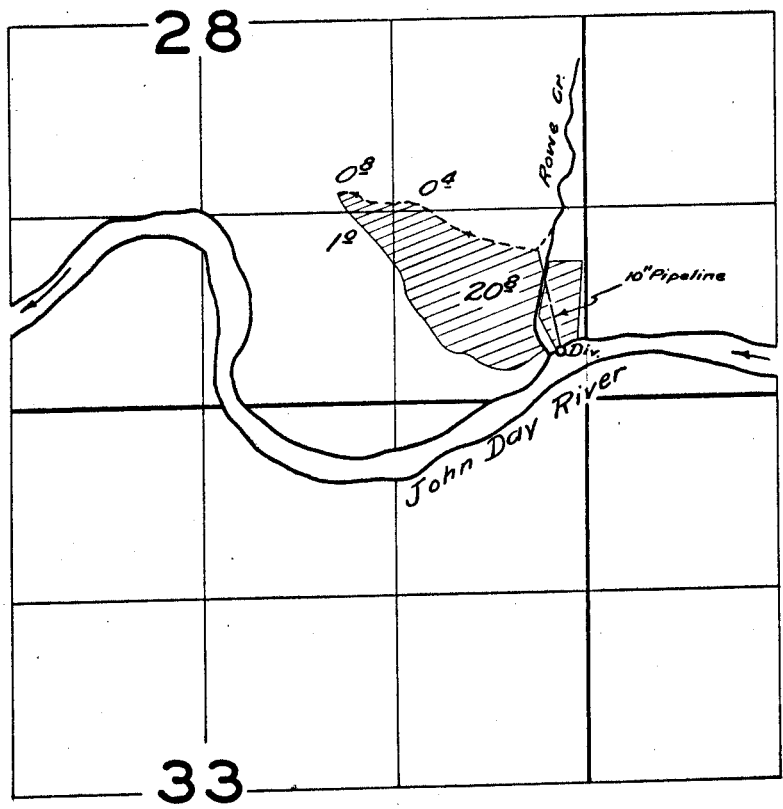

FINAL PROOF SURVEY
UNDER

Application No. 29705. Permit No. 23387.
IN NAME OF

.....*K.W. & Glendora P. Young*.....

Surveyed *June 23* 1959, by *C.B. Bartlett*.....