


T. 34-35 S. R. 6W.W.M.

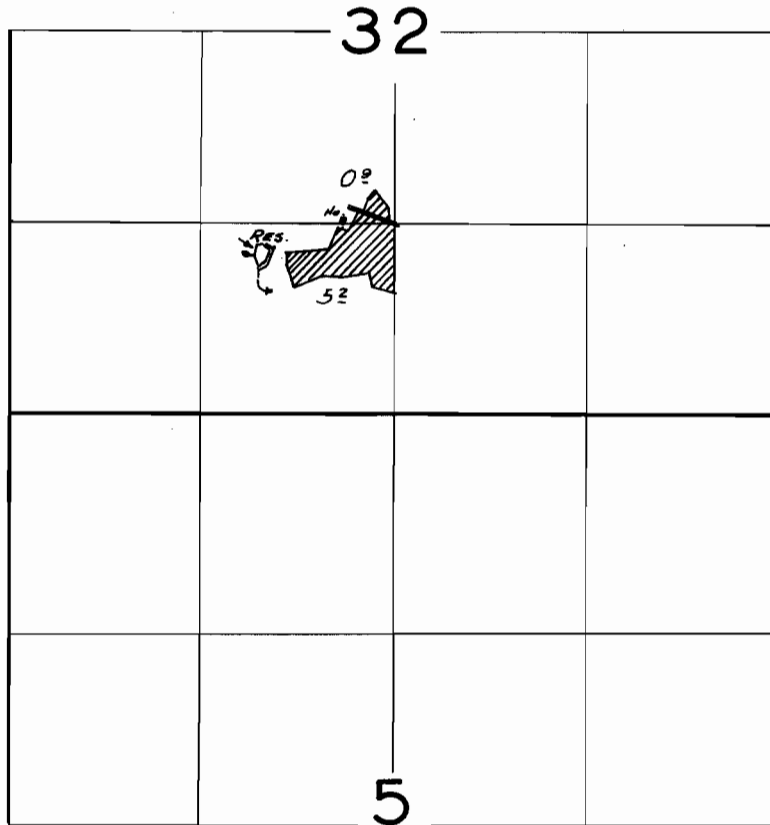

FINAL PROOF SURVEY
UNDER

Application No. 25249 Permit No. 19835
IN NAME OF

ROY J. LIVINGSTON

Surveyed July 22 1959, by R. Jackson