


T.13S. R.1E.W.M.

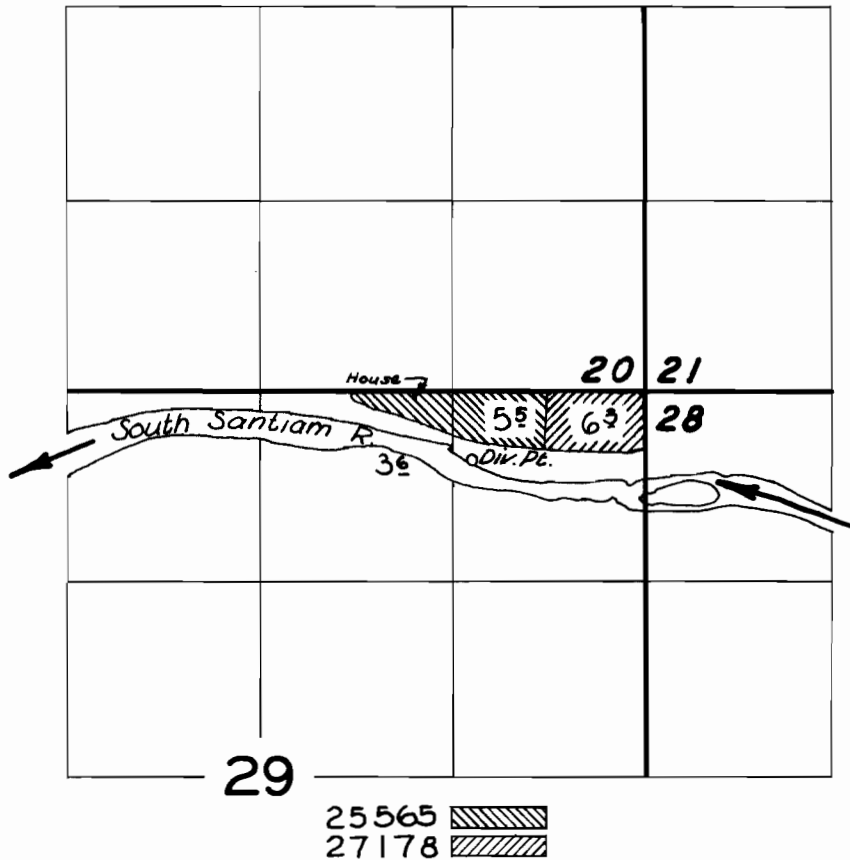

**FINAL PROOF SURVEY**  
UNDER

Application No. 25565 20071  
27178 Permit No. 21374  
IN NAME OF

**ERVIN R. & ALLEN V. KOEHEL**

Surveyed 10 Sept. 1958, by C.O. Bartels.

32