


T. 9S. R. 2W. W.M.

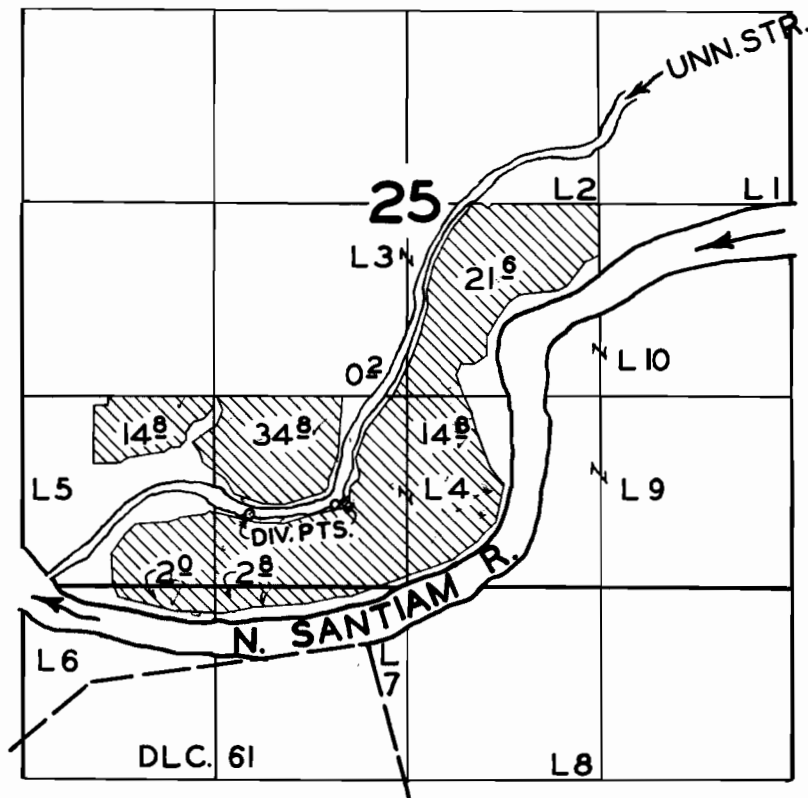

FINAL PROOF SURVEY
UNDER

Application No. 25678 Permit No. 20242
IN NAME OF

LOUIS SCOFIELD

Surveyed MAY 20 1958, by *W. C. Smith*