


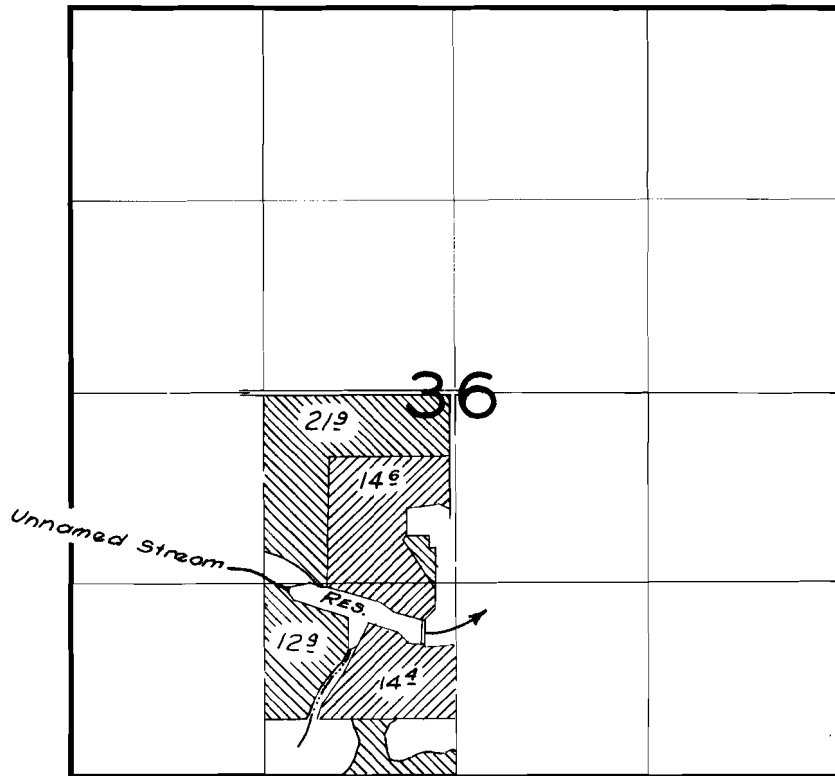


T. 1S. R. 3W.W.M.



Cert. 19863   
A-26265   
A-31140 

**FINAL PROOF SURVEY**  
UNDER

26265                      20616  
R-31139                    R-1932  
Application No. 31140      Permit No. 24482  
IN NAME OF

*ESTATE OF JOSEPH W. TWIGG*

Surveyed 25 May 1959, by *R.H. Jackson*