





T. 1 S. R. 3 W. W. M.

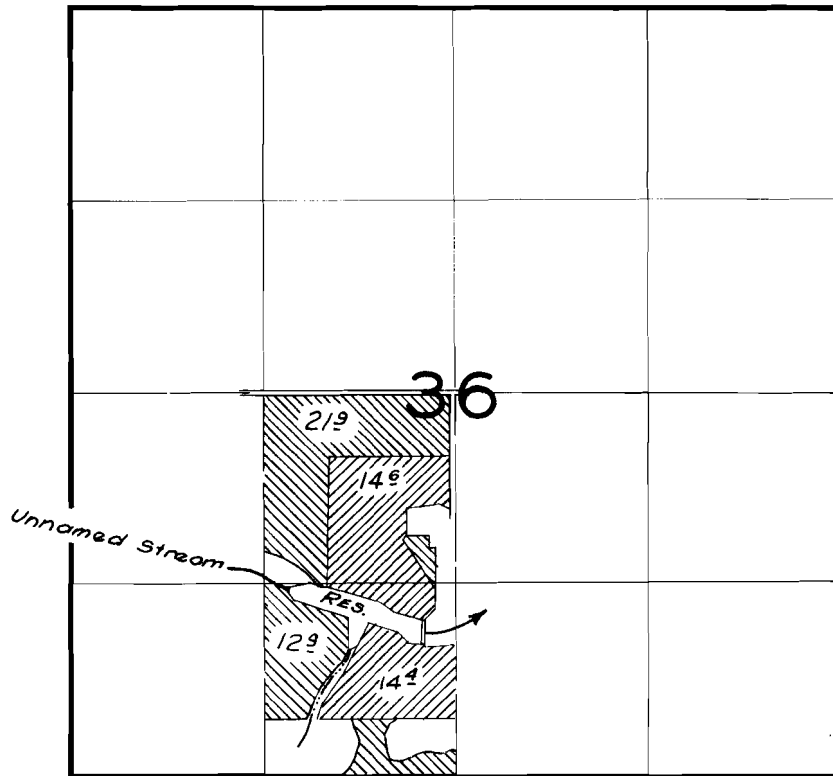

Cert. 19863 
A-26265 
A-31140 

FINAL PROOF SURVEY
UNDER

26265 20616
R-31139 R-1932
Application No. 31140 Permit No. 24482
IN NAME OF

ESTATE OF JOSEPH W. TWIGG

Surveyed 25 May 1959, by *R. H. Jackson*