


T. 35 S. R. 6 W. W. M.

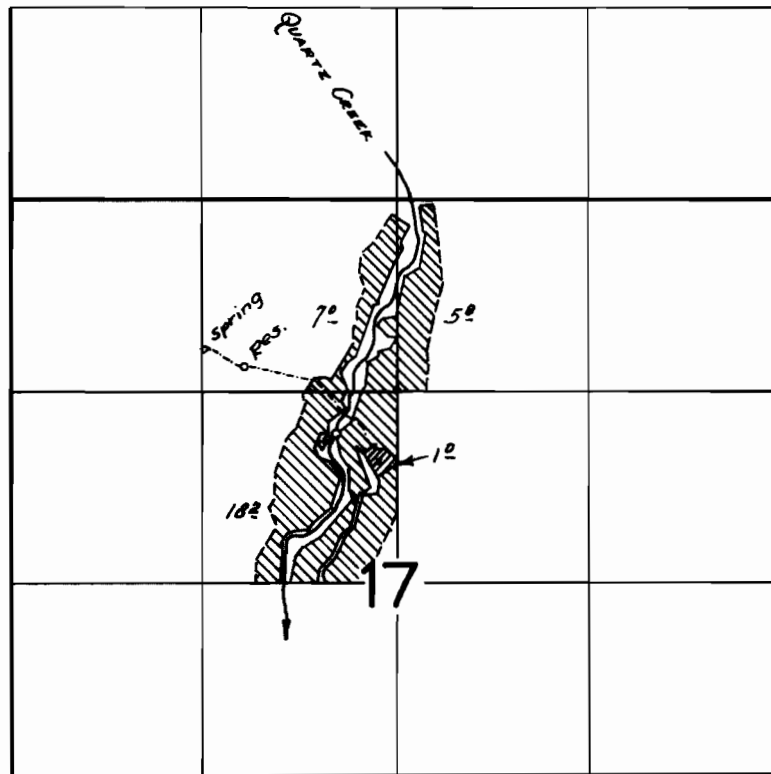

27212
30008



FINAL PROOF SURVEY
UNDER

Application No. ²⁷²¹²30008... Permit No. ²¹³⁹⁶23632...
IN NAME OF

WESLEY BANKS

Surveyed July 21, 1959, by RH Jackson